


# PLANT LEGEND

SYMBOL	BOTANICAL NAME	COMMON NAME	TYPE	LIFESPAN	SPREAD
	Erythrina Variegata	Indian Coral Tree	Tree	Perennial	10-15ft
	Cupaniopsis Anacardioides	Carrotwood	Tree	Perennial	8-12ft
	Liquidambar Styraciflua	Sweetgum	Tree	Perennial	20-50ft
	Acacia Podalyriifolia	Pearl Acacia	Tree	Perennial	8-12ft
	Pyrus Calleryana	Callery Pear	Tree	Perennial	20-30ft
	Sequoia Sempervirens	Coast Redwood	Tree	Perennial	13-26ft
	Quercus Agrifolia	Coast Live Oak	Tree	Perennial	20-49ft
	Citrus Limon	Lemon	Tree	Perennial	3-8ft
	Cinnamomum Camphora	Camphor Tree	Tree	Perennial	20ft
	Jacaranda Mimosifolia	Blue Jacaranda	Tree	Perennial	15-30ft
	Ligustrum Lucidum	Glossy Privet	Tree	Perennial	8-15ft
	Cedrus Deodara	Deodar Cedar	Tree	Perennial	10ft
	Arbutus Menziesii	Pacific Madrone	Tree	Perennial	49ft
	Phoenix Roebelenii	Pygmy Date Palm	Tree	Perennial	6-8ft
	Arbutus Unedo	Strawberry Tree	Tree/Shrub	Perennial	6-15ft
	Schinus Terebinthifolia	Brazilian Peppertree	Tree/Shrub	Perennial	25ft
	Spondias Purpurea	Jocote	Tree/Shrub	Perennial	49ft
	Dodonaea Viscosa	Florida Hopbush	Shrub	Perennial	8ft
	Lagerstroemia Indica	Crepe Myrtle	Shrub	Perennial	6-25ft
	Duranta Erecta	Golden Dewdrop	Shrub	Perennial	2-10ft
	Hesperoyucca Whipplei	Chaparral Yucca	Shrub	Perennial	2-7ft
	Agave Attenuata	Foxtail Agave	Shrub	Perennial	6in-8ft
	Rhododendron Indicum	Southern Indian Azalea	Shrub	Perennial	2-3ft
	Rosa Hybrida	Tea Rose	Shrub	Perennial	2-3ft
	Acer Palmatum	Japanese Maple	Shrub	Perennial	20ft
	Rosa Chinensis	China Rose	Vine/Shrub	Perennial	3-6ft
	Rosa Canina	Dog Rose	Vine/Shrub	Perennial	3-15ft
	Salvia Rosmarinus	Rosemary	Herb/Shrub	Perennial	2-4ft
	Clivia Miniata	Natal Lily	Herb/Shrub	Perennial/Annual	2-3ft
	Phormium Tenax	New Zealand Flax	Herb/Shrub	Perennial/Annual	1-3ft

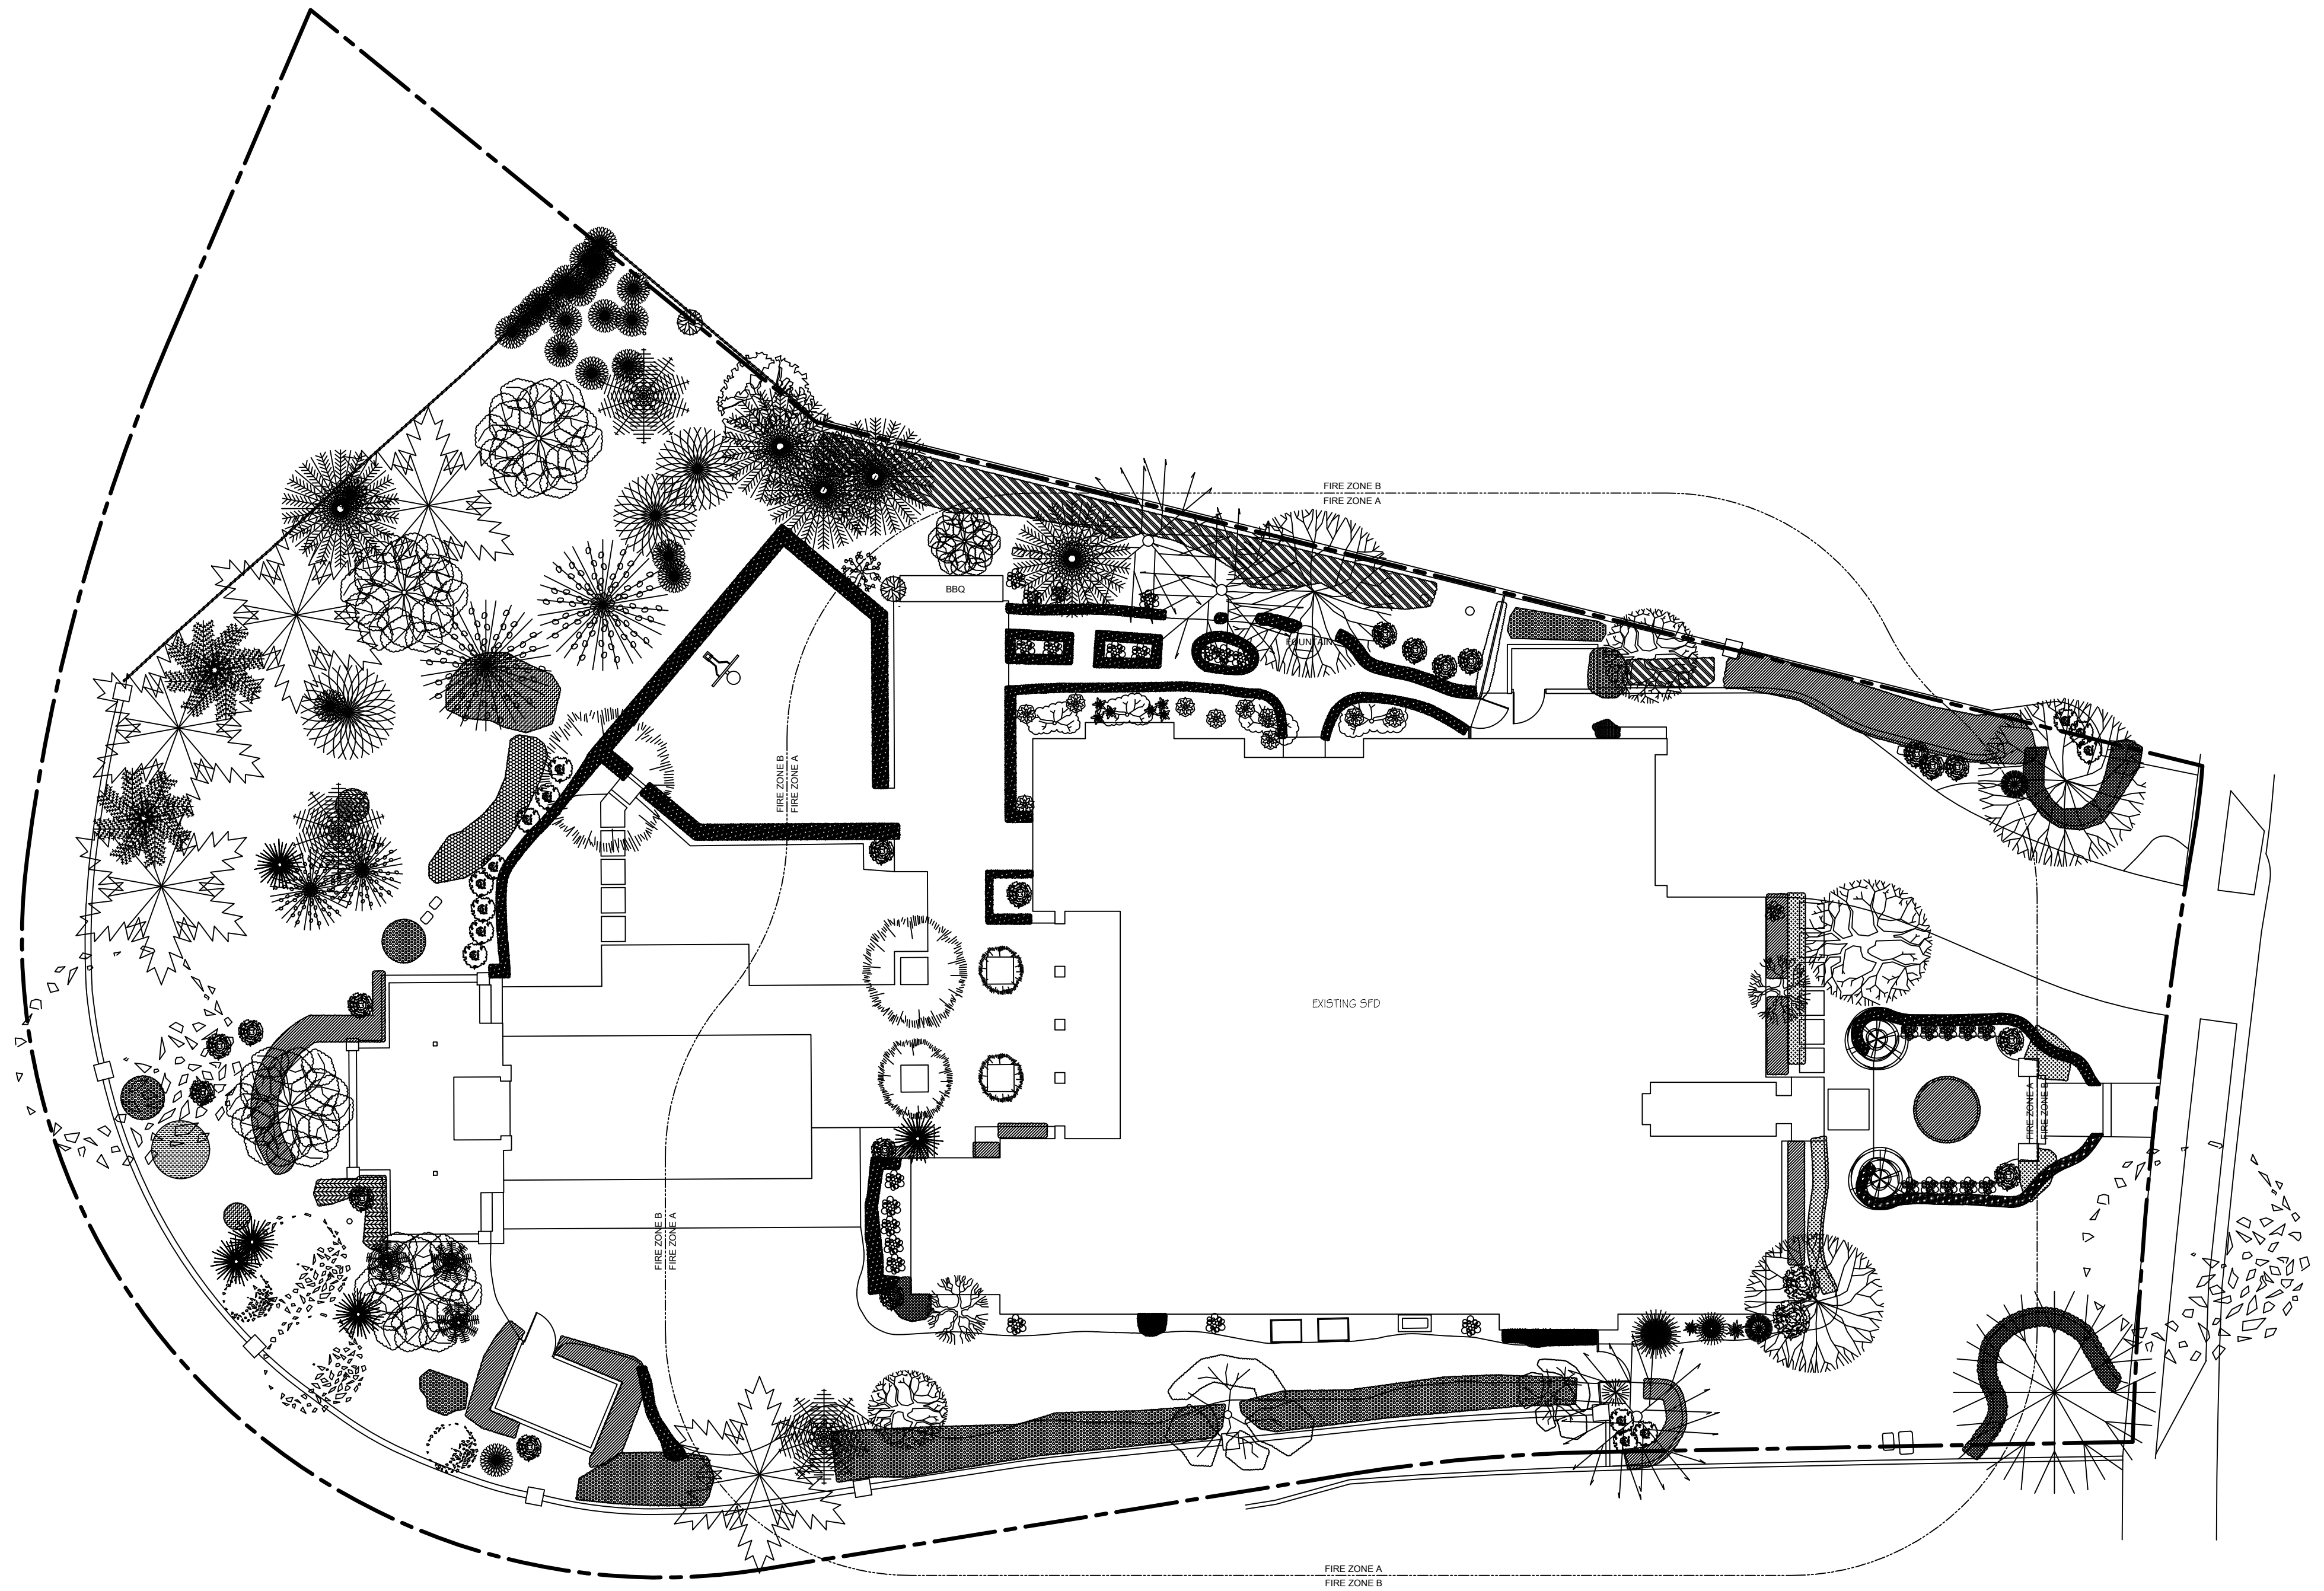

**A AS-BUILT SITE PLAN**  
Scale: 3/16" = 1'-0"

SYMBOL	BOTANICAL NAME	COMMON NAME	TYPE	LIFESPAN	SPREAD
	Liriope Muscari	Lilyturf	Herb	Perennial/Annual	1-2ft
	Cenchrus Setaceus	African Fountain Grass	Grass	Perennial/Annual	2-4ft
	Pyrostegia Venusta	Flamevine	Vine	Perennial	6-8ft
	Prunus Caroliniana	Carolina Cherry Laurel	Tree	Perennial	20-30ft
	Scolopia Saeva	Scolopia Saeva	Tree	Perennial	13-33ft
	Ilex Vomitoria	Yaupon	Tree	Perennial	8-12ft
	Euonymus Japonicus	Japanese Spindletree	Tree/Shrub	Perennial	7ft
	Frangula Californica	California Coffeeberry	Shrub	Perennial	5-15ft
	Baccharis Pilularis	Coyote Brush	Shrub	Perennial	4ft

SYMBOL	BOTANICAL NAME	COMMON NAME	TYPE	LIFESPAN	SPREAD
	Nandina Domestica	Heavenly Bamboo	Shrub	Perennial	5ft
	Buxus Sinica var. Parvifolia	Boxwood	Shrub	Perennial	3-6ft
	Loropetalum Chinese var. Rubrum	Chinese Fringe Flower	Shrub	Perennial	3-6ft
	Rhapiolepis Indica	Indian Hawthorn	Shrub	Perennial	3-6ft
	Myrtus Communis	Common Myrtle	Shrub	Perennial	8-12ft
	Cotoneaster Integerrimus	Common Cotoneaster	Shrub	Perennial	4-8ft

SHEET TITLE	REVISIONS
	JOB NO: #####
	DATE: / /
	DRAWN:

