


2372 MORSE AVE | STE 304


MULTI-FAMILY

12345 MAIN ST



FLOOR PLAN

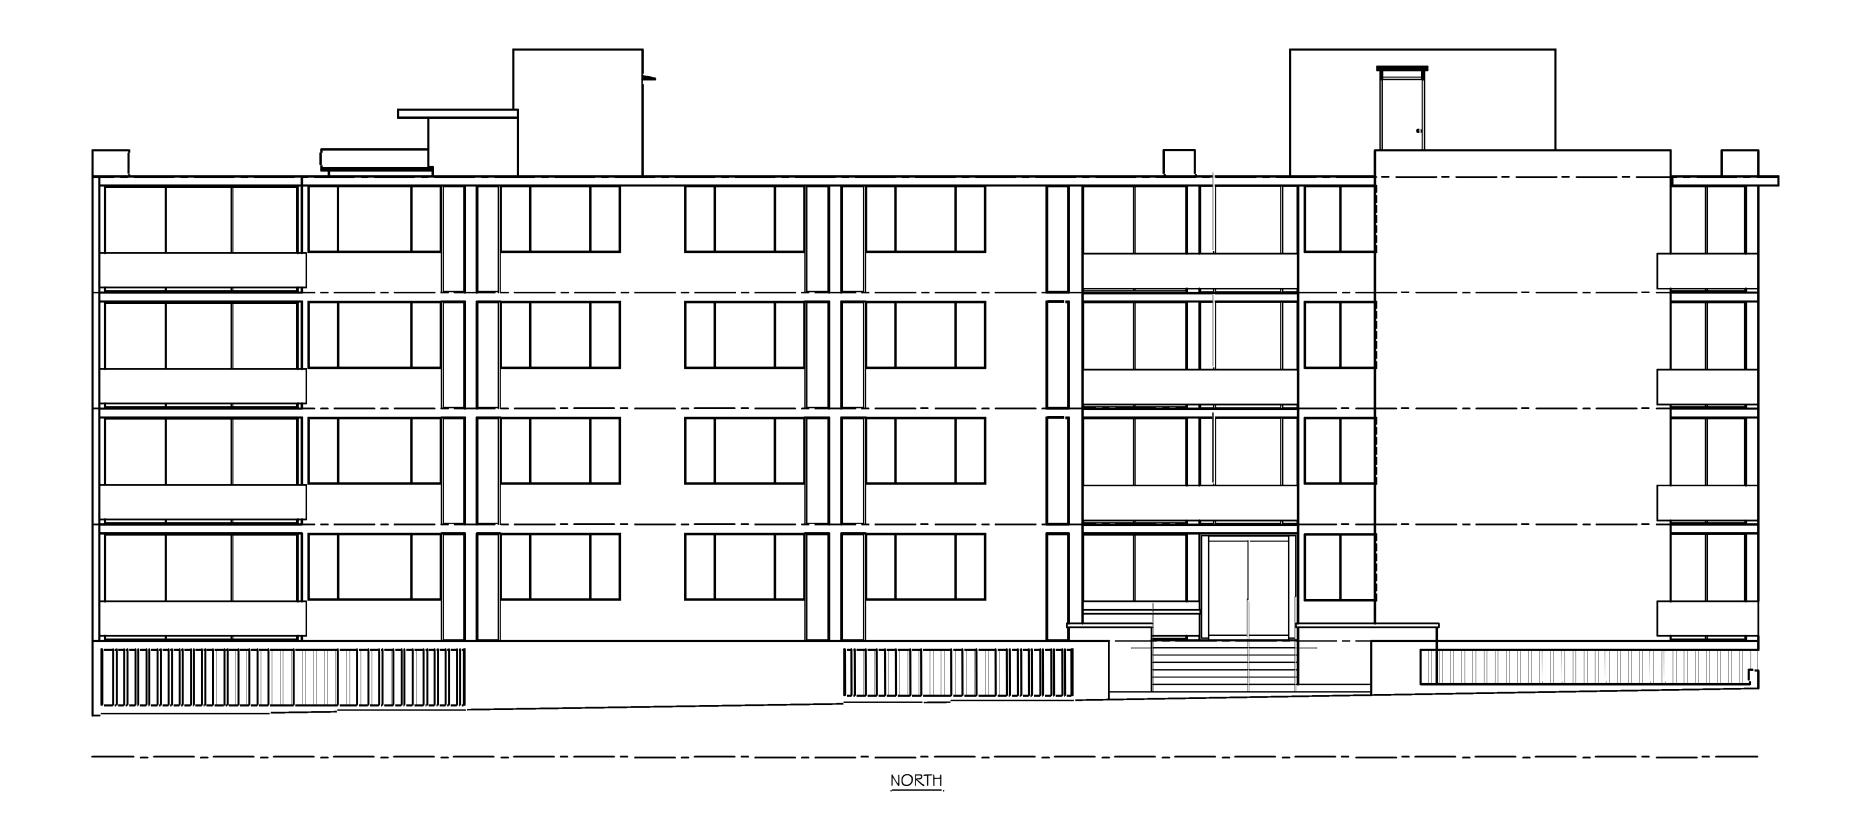

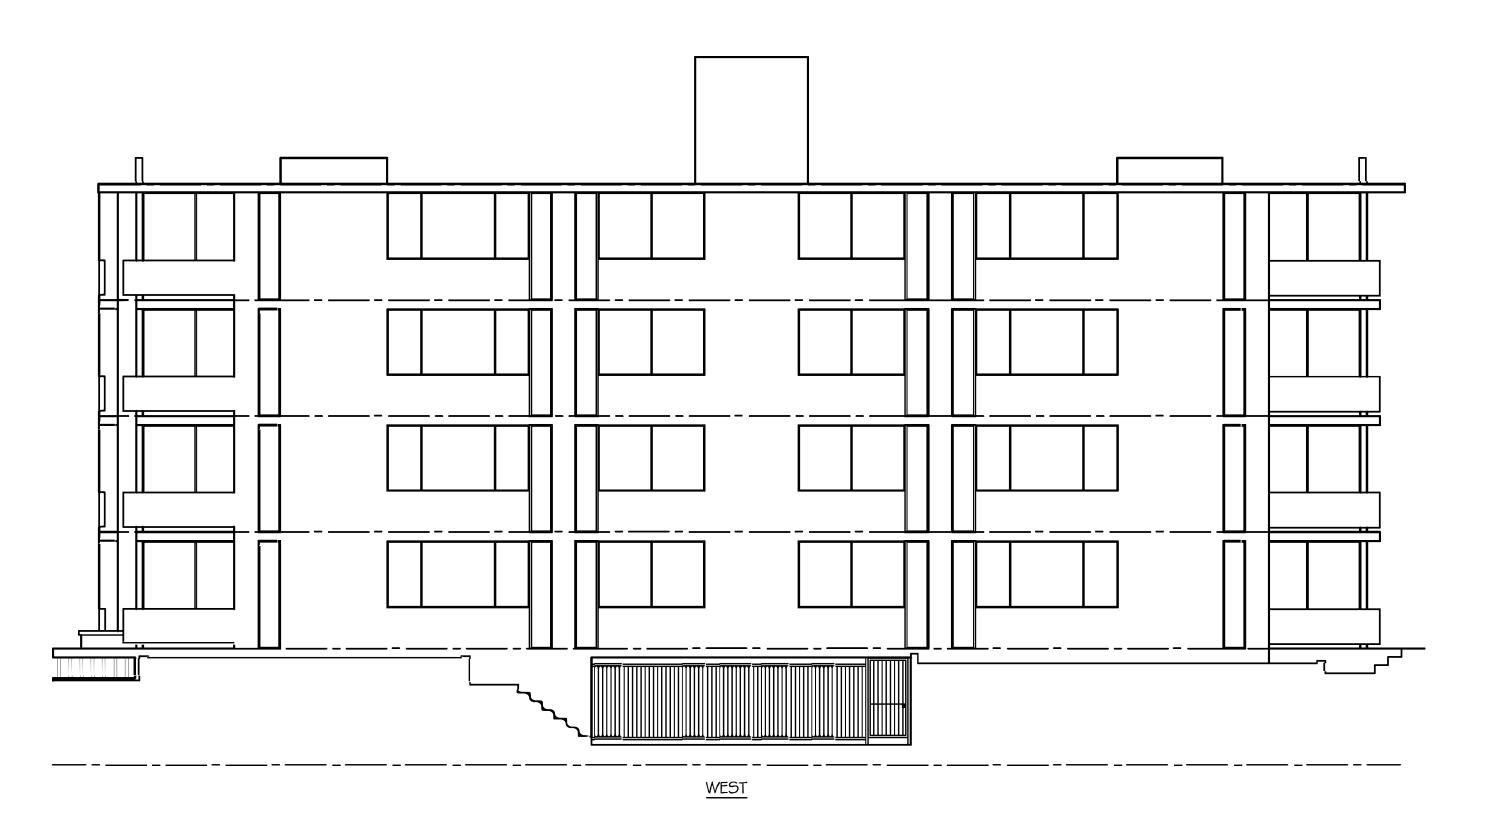

2372 MORSE AVE | STE 304 IRVINE, CA 92614 T: 424-201-0808 W: MOSAIQUS.COM

REVISIONS

<u></u> -

PREPARED FOR

MULTI-FAMILY

PROJECT NAME

SANTA ANA

PROJECT ADDRESS

12345 MAIN ST LAGUNA BEACH, CA 92651

PROJECT APN#

All plans created by Mosaiq LLC "Mosaiq" are made exclusively for design reference only (Cal. Bus. & Prof.

Code §8727). All site plans created by Mosaiq do not involve the determination of any property line, and as such do not constitute land surveying

(Cal. Bus. & Prof. Code §§8726-8727). In addition, Mosaiq services and plans do not constitution evid engineering (Cal. Bus. & Prof. Code §§8726-8727). In addition, Mosaiq services and plans do not constitution by the used for any studies or activities defined as civil engineering (Cal. Bus. & Prof. Code §6731). All floor plans created by Mosaiq are intended to be used as a reference for design and construction and should not be considered a substitute for the services of a licensed structural engineer or licensed architect. Mosaiq makes every reasonable effort to ensure the accuracy of the information found in our plans. However, every As-Built drawing inherently contains errors to some degree. It is the duty of the architect, contractor, designer or other licensed professional, as a consultant to the property owner, to determine the suitability of the As-Built plans prior to construction. Measurements should be field confirmed before commencing construction. in the event that an error is found on a plan, Mosaiq's liability is limited to the amount of the fee paid to Mosaiq.

SCALE SCALE 1/4" = 1'-0"

PROJECT PROJECT M2208-019


SHEET


APPROVED BY

2025-12-31

DRAWING TYPE **EXTERIOR ELEVATIONS**

2 of 3

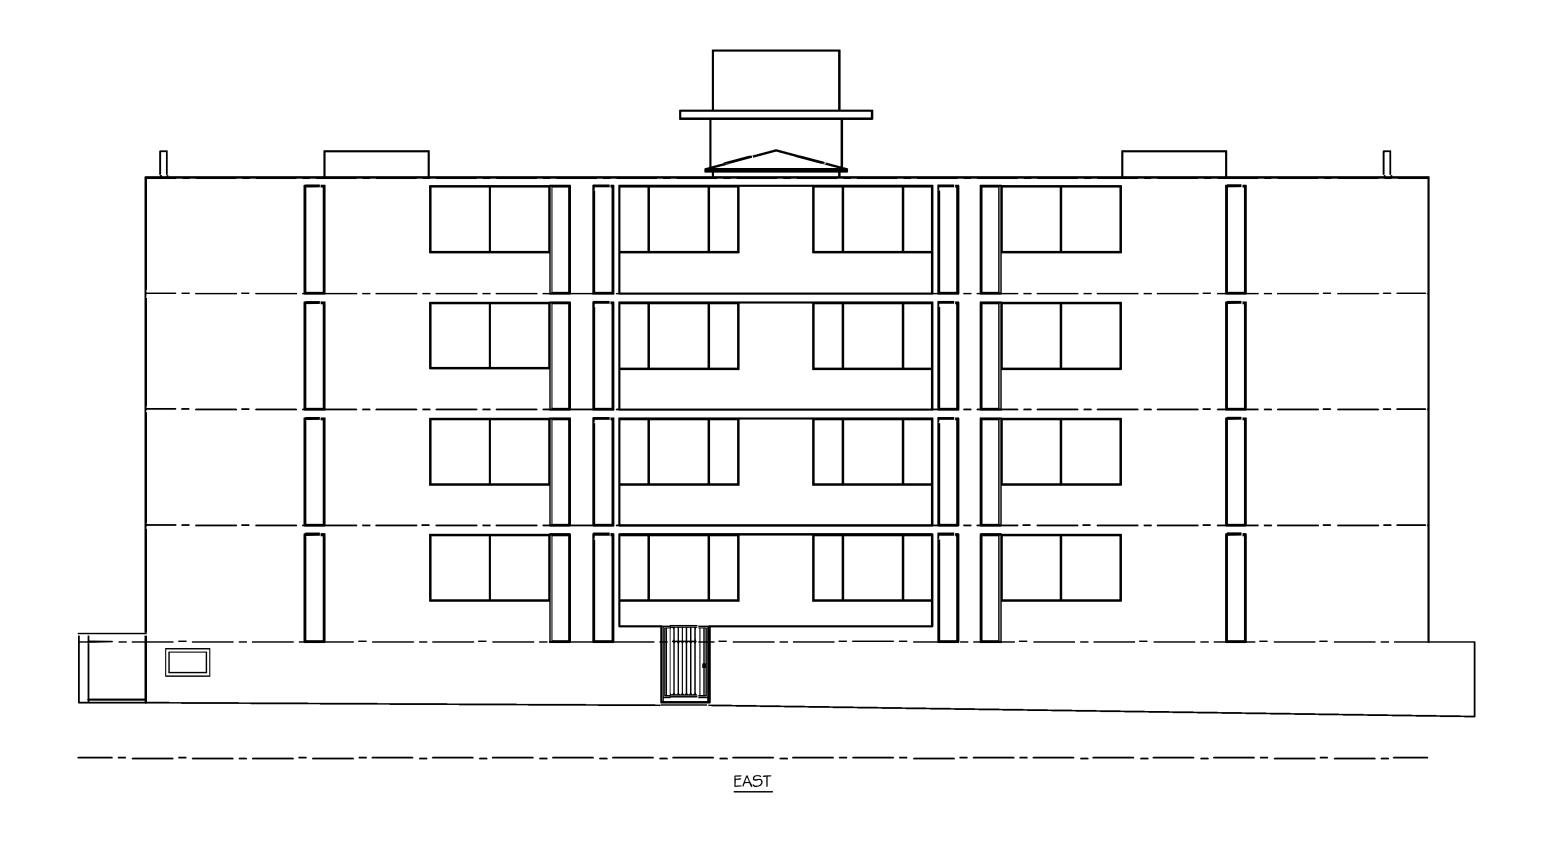

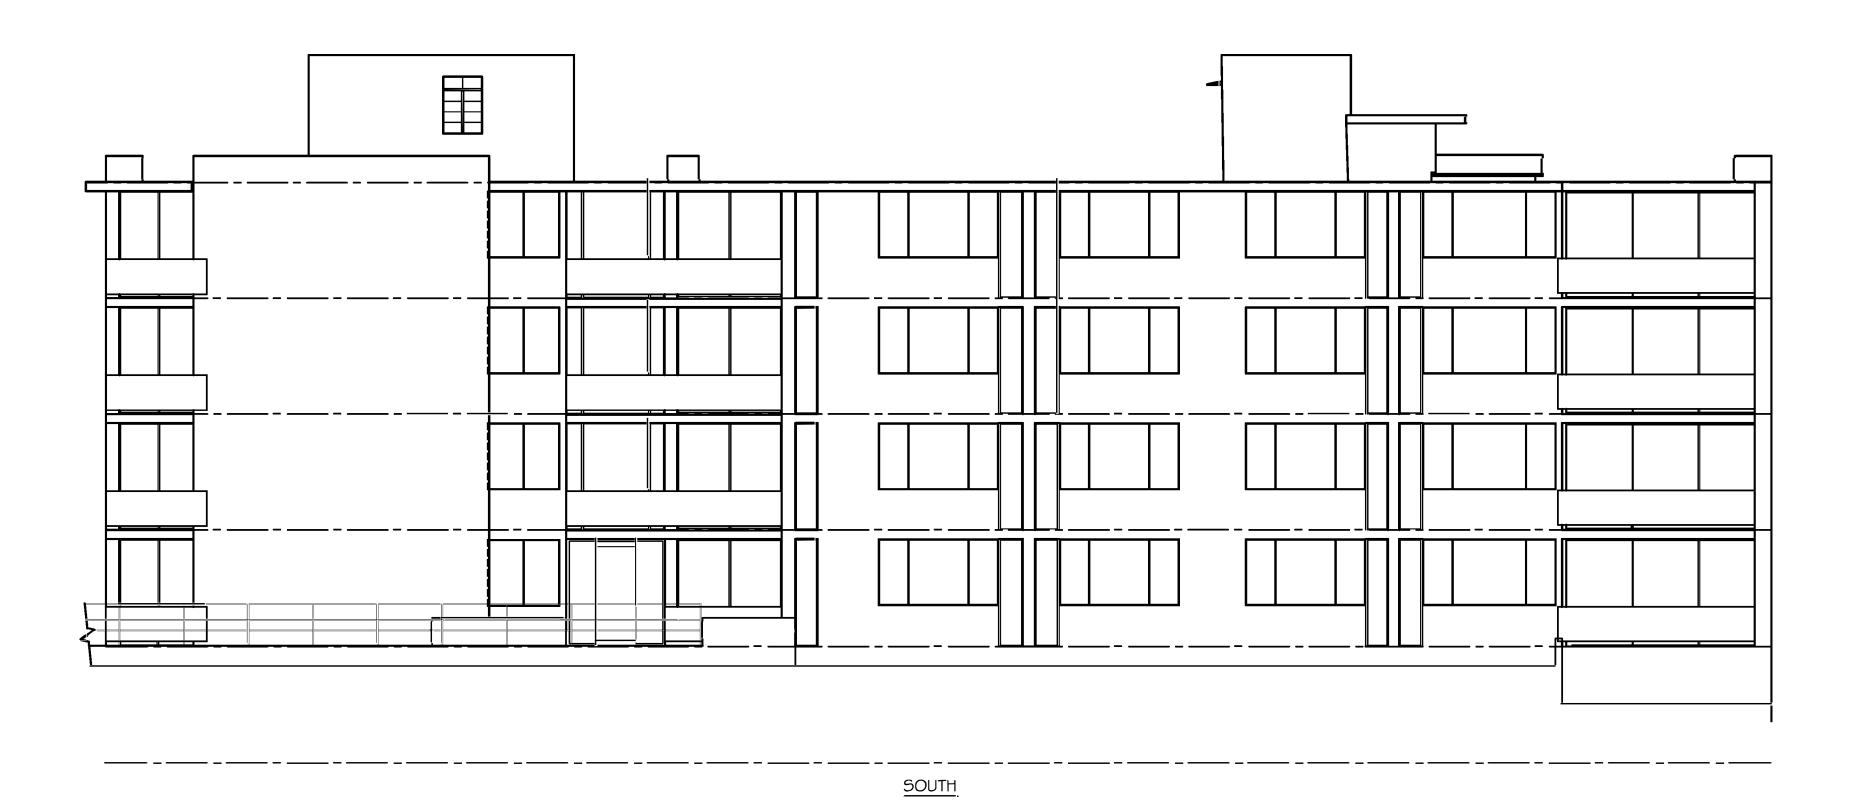

MOSAL EXPLORE THE BUILT ENVIRONMENT

2372 MORSE AVE | STE 304 IRVINE, CA 92614 T: 424-201-0808 W: MOSAIQUS.COM

REVISIONS



PREPARED FOR

MULTI-FAMILY

PROJECT NAME

SANTA ANA

PROJECT ADDRESS

12345 MAIN ST LAGUNA BEACH, CA 92651

PROJECT APN#

######

All plans created by Mosaiq LLC "Mosaiq" are made exclusively for design reference only (Cal. Bus. & Prof.

Code §8727). All site plans created by Mosaiq do not involve the determination of any property line, and as such do not constitute land surveying

(Cal. Bus. & Prof. Code §§8726-8727). In addition, Mosaiq services and plans do not constitution evid engineering (Cal. Bus. & Prof. Code §§8726-8727). In addition, Mosaiq services and plans do not constitution by the used for any studies or activities defined as civil engineering (Cal. Bus. & Prof. Code §6731). All floor plans created by Mosaiq are intended to be used as a reference for design and construction and should not be considered a substitute for the services of a licensed structural engineer or licensed architect. Mosaiq makes every reasonable effort to ensure the accuracy of the information found in our plans. However, every As-Built drawing inherently contains errors to some degree. It is the duty of the architect, contractor, designer or other licensed professional, as a consultant to the property owner, to determine the suitability of the As-Built plans prior to construction. Measurements should be field confirmed before commencing construction. in the event that an error is found on a plan, Mosaiq's liability is limited to the amount of the fee paid to Mosaiq.

SCALE SCALE //4" = 1'-0"

 $\frac{1}{4}$ " = 1'-0'
PROJECT PROJECT

M2208-019
APPROVED BY

TC

2025-12-31
DRAWING TYPE

EXTERIOR ELEVATIONS

3 of 3