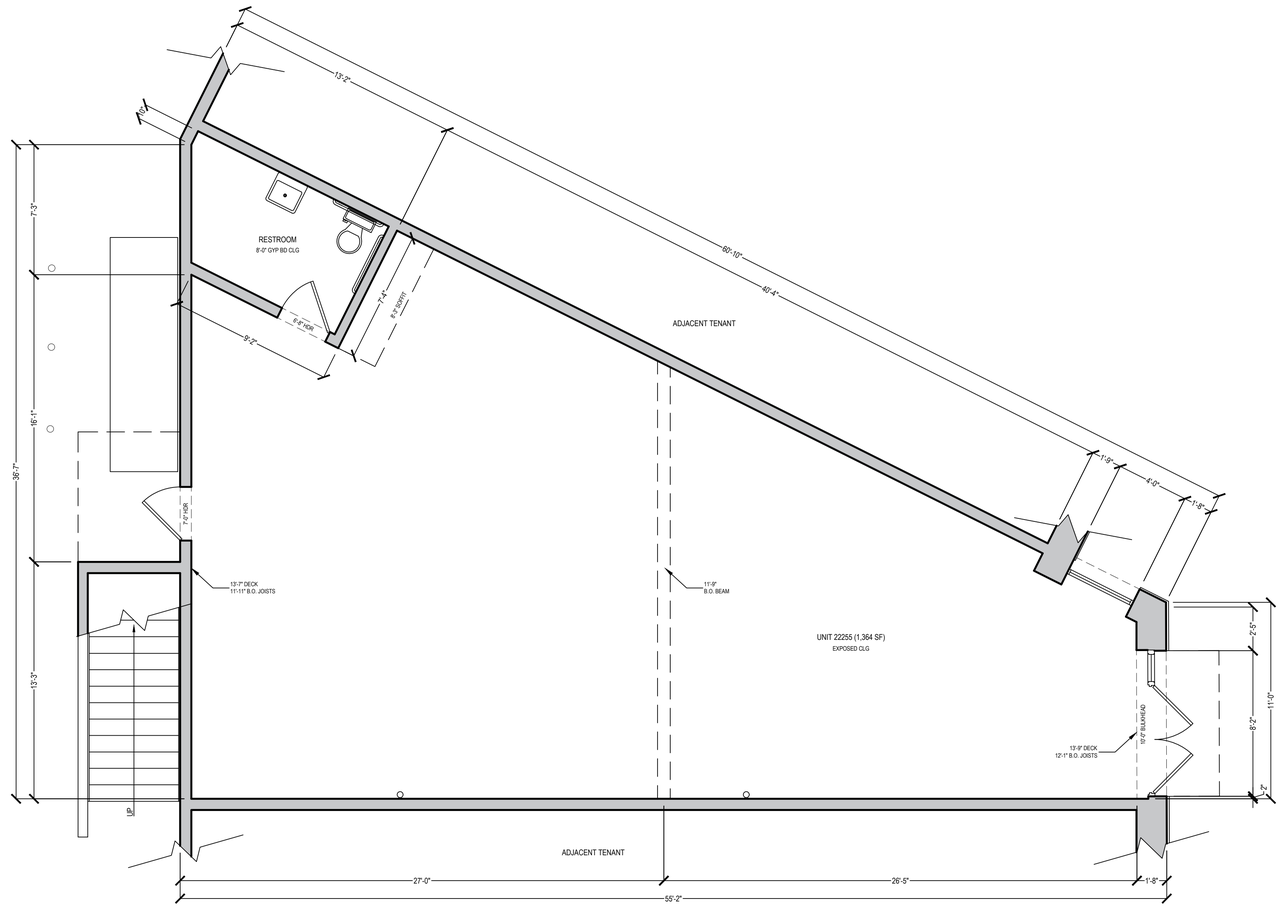

DRAWING LEGEND:

COUNTER

UPPER CABINET

FULL HEIGHT CABINET

CLG = CEILING HEIGHT

MOSAIQ
EXPLORE THE BUILT ENVIRONMENT

2372 MORSE AVE | STE 304
IRVINE, CA 92614
T: 818-613-1215
W: MOSAIQUS.COM

REVISIONS

1 -

PREPARED FOR

PROPERTY MANAGER

PROJECT NAME

GELSONS VILLAGE

PROJECT ADDRESS

123 MAIN ST
ANYTOWN, USA

PROJECT APN#

n/a

All plans created by Mosaiq LLC "Mosaiq" are made exclusively for design reference only (Cal. Bus. & Prof. Code §6727). All site plans created by Mosaiq do not involve the determination of any property line, and as such do not constitute land surveying. (Cal. Bus. & Prof. Code §6732-6737). In addition, Mosaiq services and plans do not constitute civil engineering (Cal. Bus. & Prof. Code §6732-6734), and thus should not be used for any studies or activities defined as civil engineering (Cal. Bus. & Prof. Code §6731). All floor plans created by Mosaiq are intended to be used as a reference for design and construction and should not be considered a substitute for the services of a licensed structural engineer or licensed architect. Mosaiq makes every reasonable effort to ensure the accuracy of the information found in our plans. However, every As-Built drawing inherently contains errors to some degree. It is the duty of the architect, contractor, designer or other licensed professional, as a consultant to the property owner, to determine the suitability of the As-Built plans prior to construction. Measurements should be field confirmed before commencing construction. In the event that an error is found on a plan, Mosaiq's liability is limited to the amount of the fee paid to Mosaiq.

SCALE

¼" = 1'-0"

PROJECT

m2603-16

APPROVED BY

TC

DATE

2026-03-16

DRAWING TYPE

LOD UNIT 22255

SHEET

1 of 1