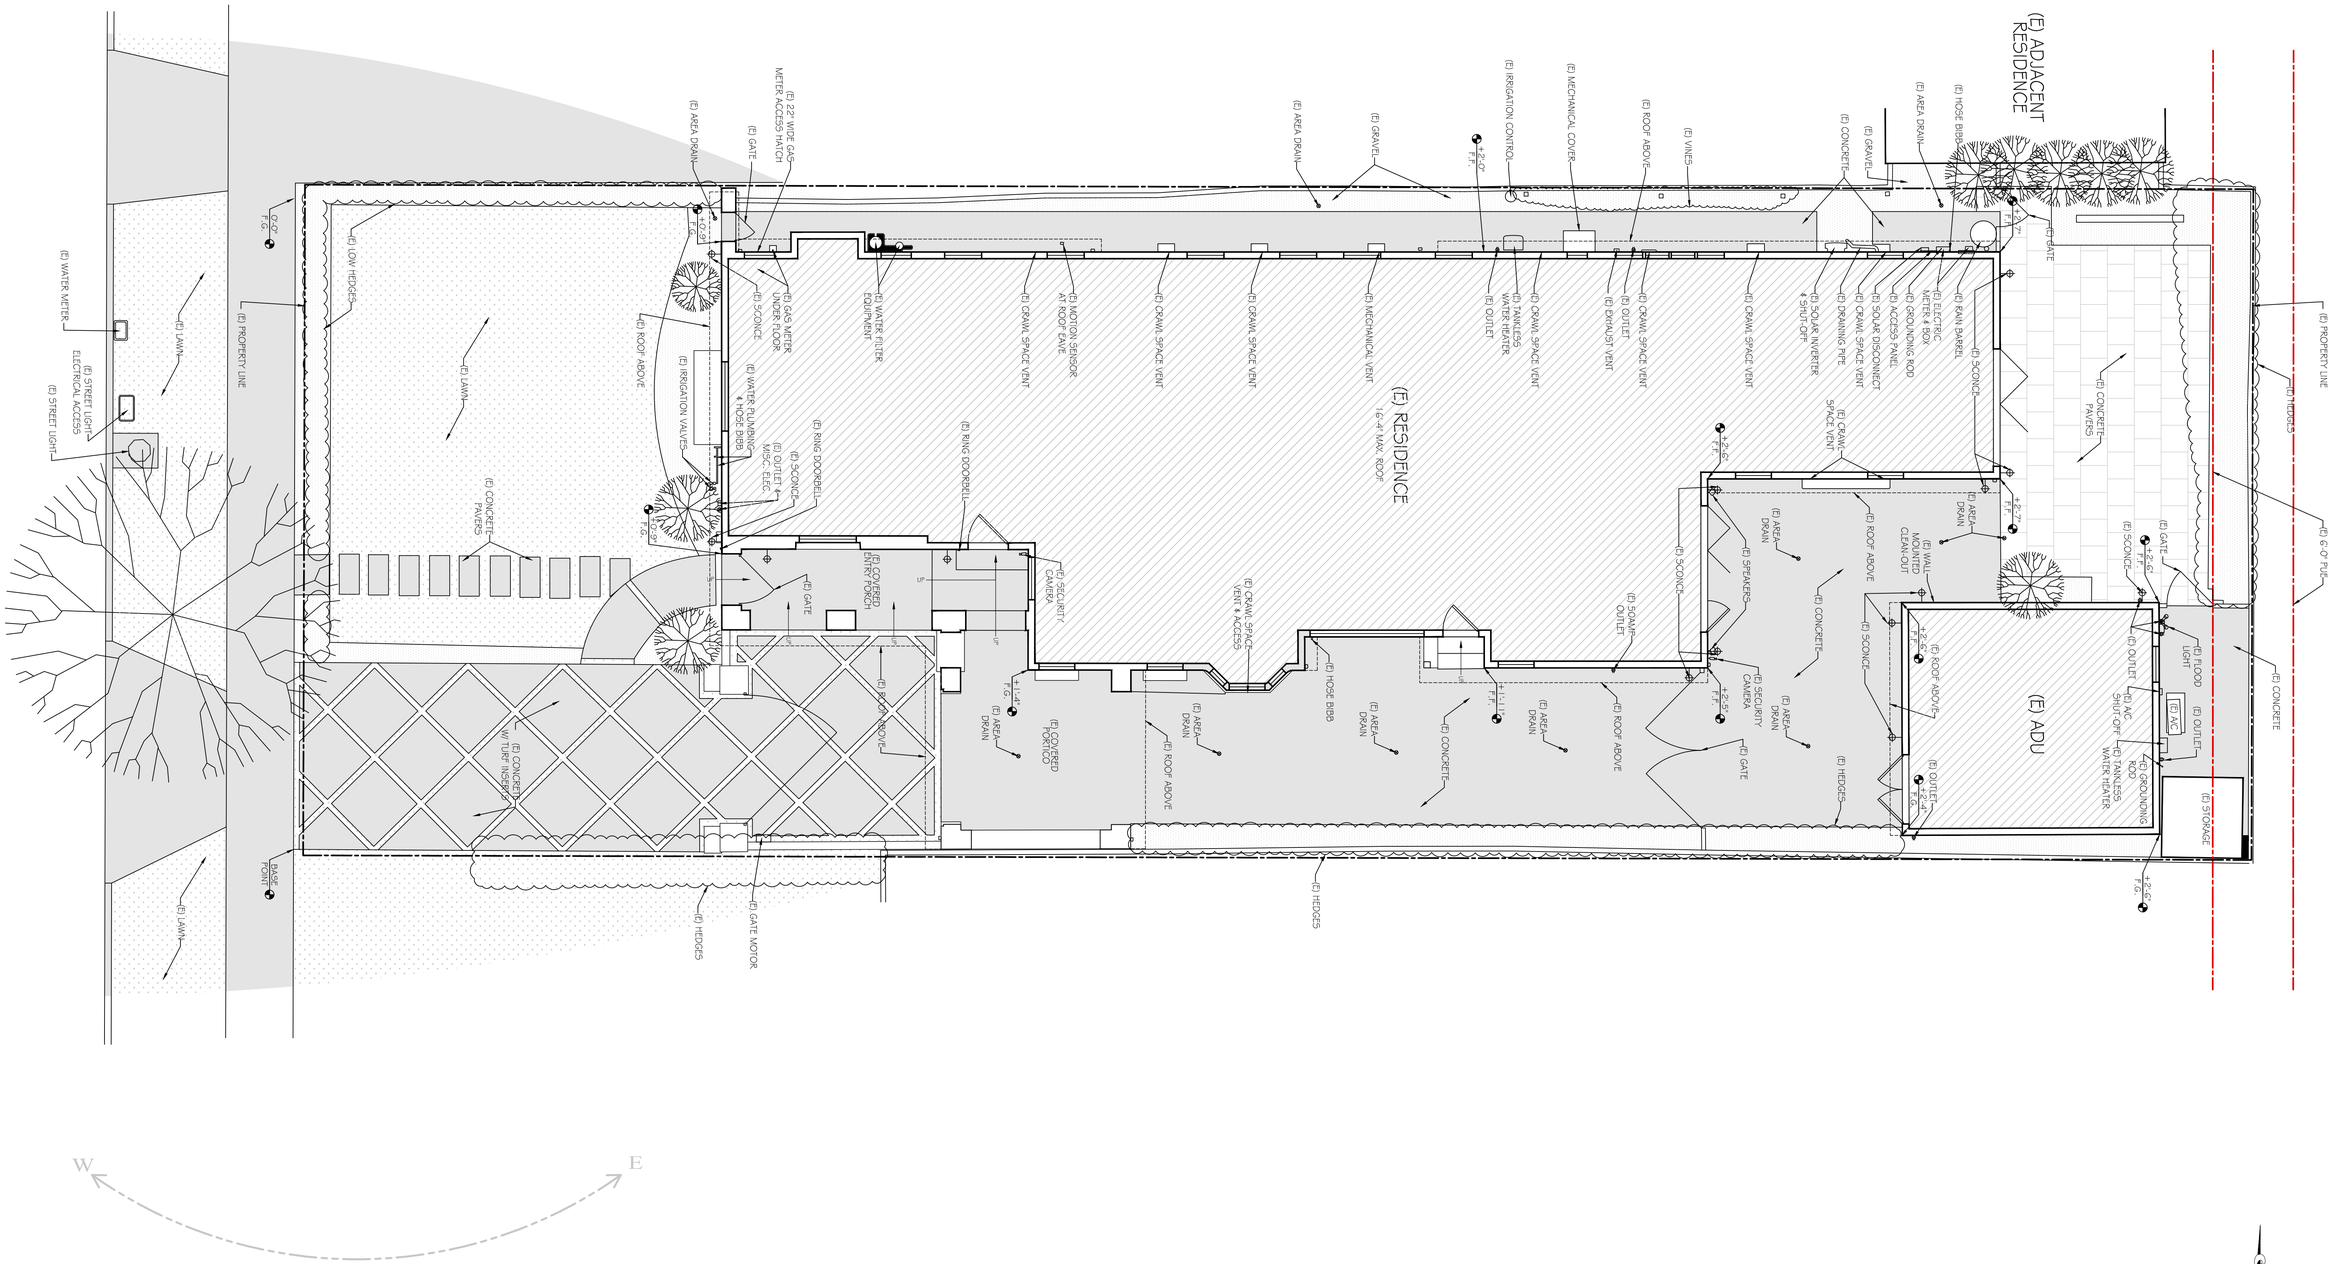

SCALE: 3/16" = 1'-0"

ABBREVIATIONS LEGEND:
T.O.C. = Top of Curb
B.O.C. = Bottom of Curb
T.O.S. = Top of Stairs
B.O.S. = Bottom of Stairs
T.O.W. = Top of Wall
B.O.W. = Bottom of Wall
F.F. = Finish Floor
F.G. = Finish Grade

MOSAIQ
EXPLORE THE BUILT ENVIRONMENT
2372 MORSE AVE | STE 304
IRVINE, CA 92614
T: 424-201-0808
W: MOSAIQUS.COM

REVISIONS
1 -

PREPARED FOR
RESIDENCE

PROJECT NAME
SANTA ANA

PROJECT ADDRESS
12345 MAIN ST
LAGUNA BEACH, CA 92651

PROJECT APN#
######

All plans created by Mosaiq LLC "Mosaiq" are made exclusively for design reference only (Cal. Bus. & Prof. Code §6727). All site plans created by Mosaiq do not involve the determination of any property line, and as such do not constitute land surveying. (Cal. Bus. & Prof. Code §6730-6737). In addition, Mosaiq services and plans do not constitute civil engineering (Cal. Bus. & Prof. Code §6702-6704) and thus should not be used for any studies or activities defined as civil engineering (Cal. Bus. & Prof. Code §6731). All floor plans created by Mosaiq are intended to be used as a reference for design and construction and should not be considered a substitute for the services of a licensed structural engineer or licensed architect. Mosaiq makes every reasonable effort to ensure the accuracy of the information found in our plans. However, every As-Built drawing inherently contains errors to some degree. It is the duty of the architect, contractor, designer or other licensed professional, as a consultant to the property owner, to determine the suitability of the As-Built plans prior to construction. Measurements should be field confirmed before commencing construction. In the event that an error is found on a plan, Mosaiq's liability is limited to the amount of the fee paid to Mosaiq.

SCALE SCALE
3/16" = 1'-0"

PROJECT PROJECT
M2208-019

APPROVED BY
TC

DATE
2025-12-31

DRAWING TYPE
SITE PLAN

SHEET
1 of 1