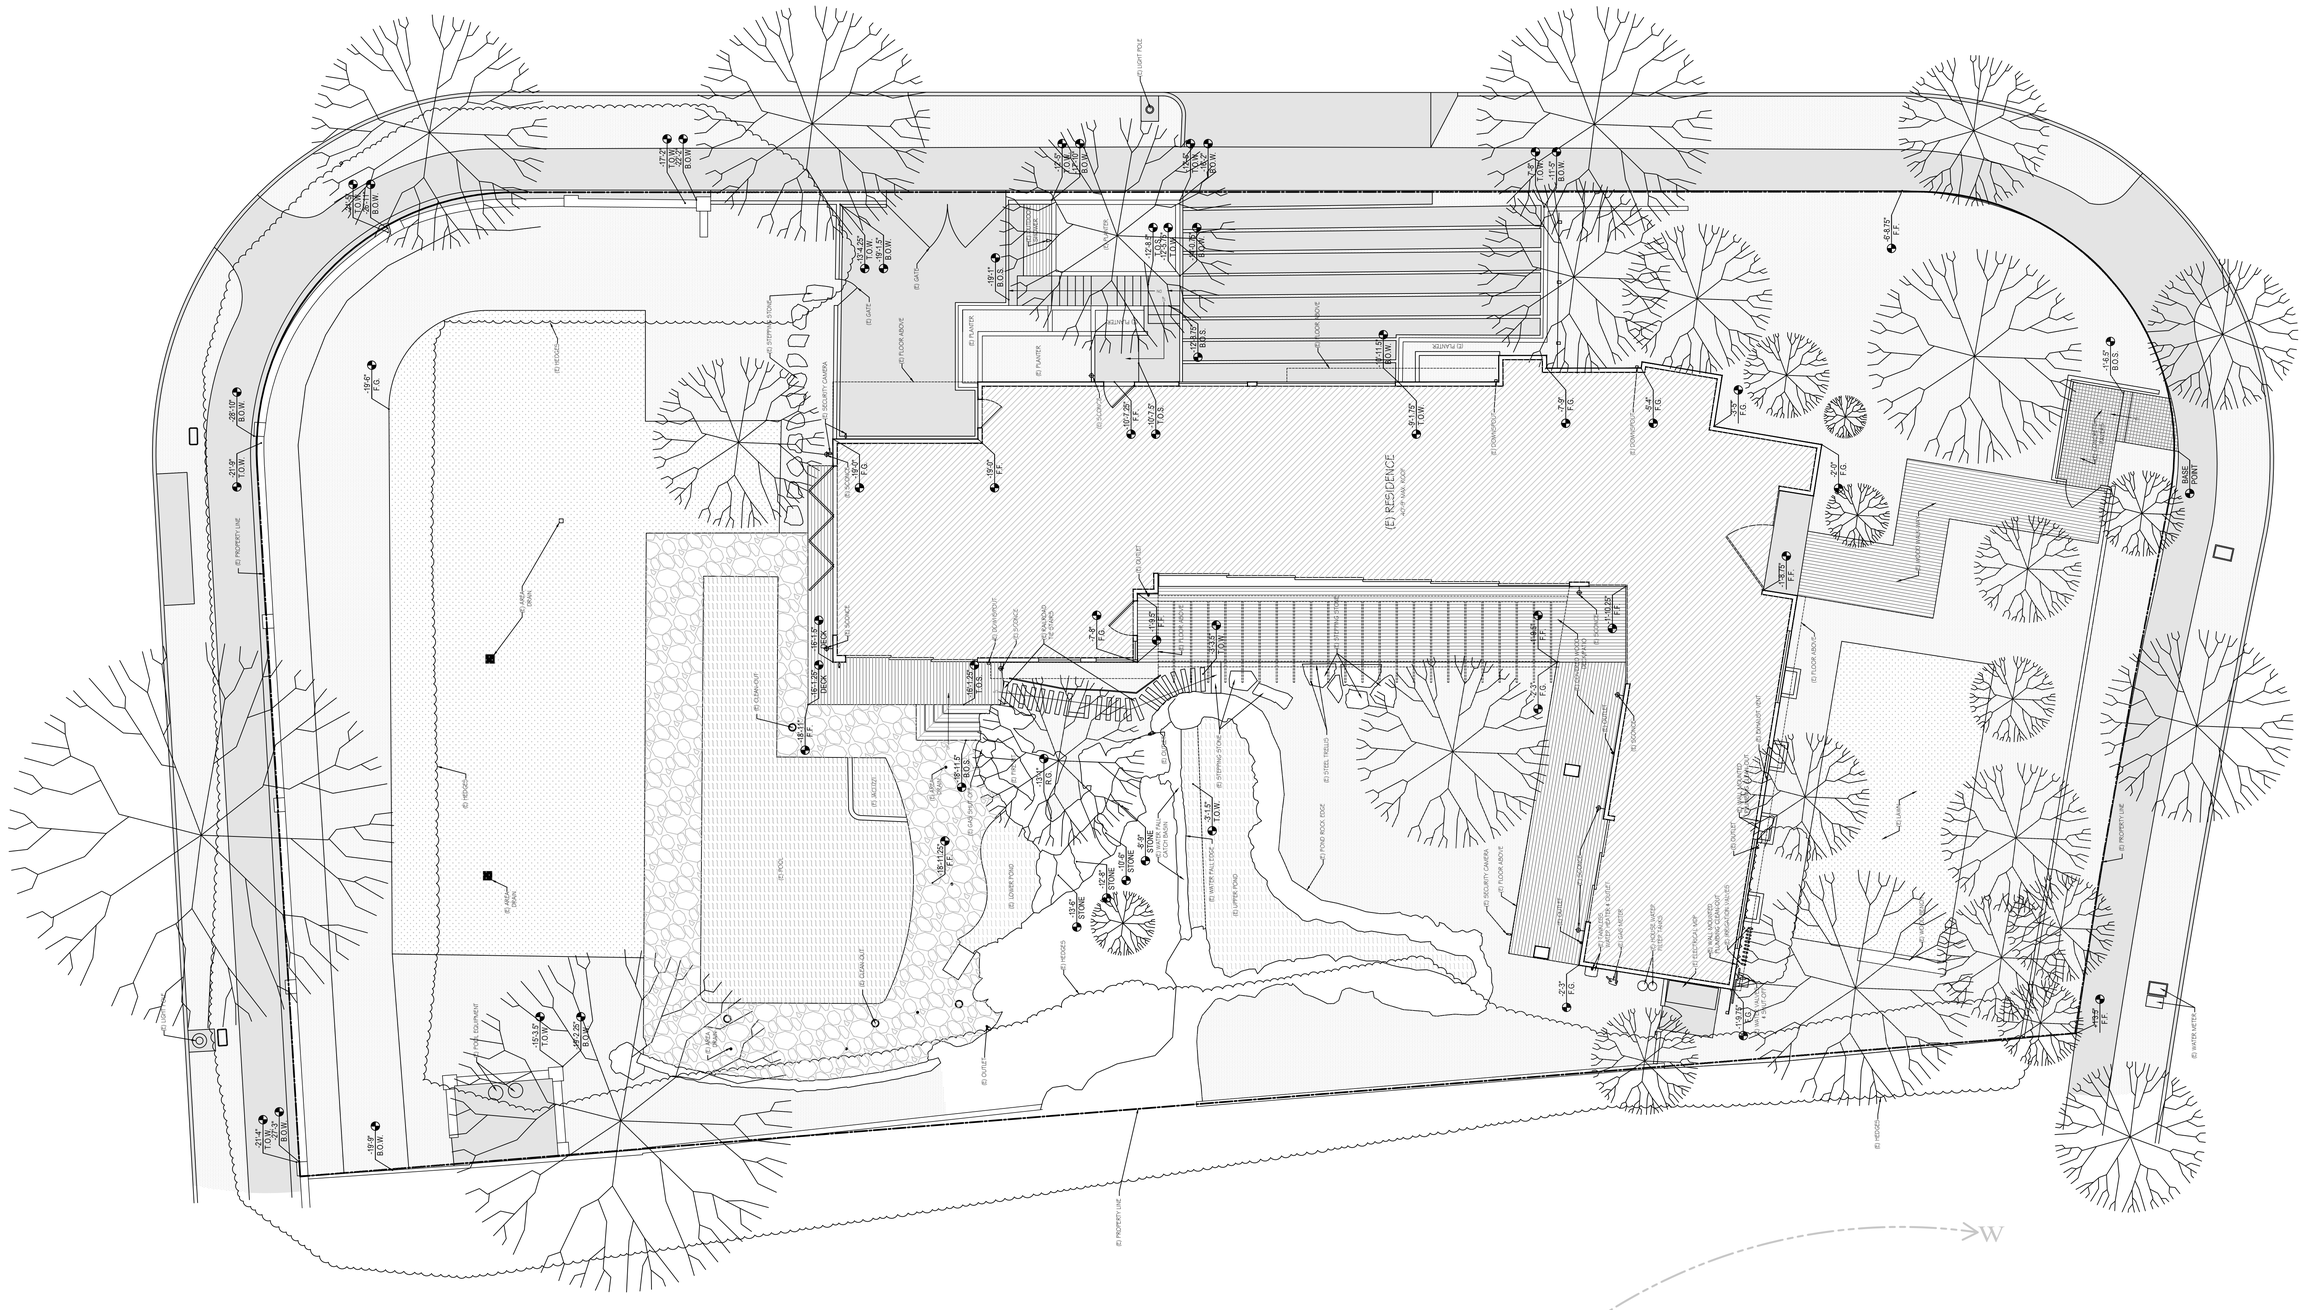

(E) RESIDENCE
(E) PROPERTY LINE
(E) HEDGE
(E) FENCE
(E) GATE
(E) PLANTER
(E) STEPPING STONE
(E) SECURITY CAMERA
(E) FLOOR ABOVE
(E) LIGHT POLE
(E) LIGHT
(E) DRIVEWAY
(E) GROUND
(E) DECKING
(E) STEEL TRELLIS
(E) POND ROCK EDGE
(E) UPPER POND
(E) LOWER POND
(E) WATER FALL EDGE
(E) WATER FALL
(E) CLEAN OUT
(E) OUTLET
(E) EQUIPMENT
(E) WATER METER
(E) ELECTRICAL BOX
(E) PLUMBING CLEAN OUT
(E) HOSE BIB
(E) HOUSE WATER METER HEAD
(E) GAS METER
(E) GAS LINE
(E) WATER METER
(E) MAIL BOX
