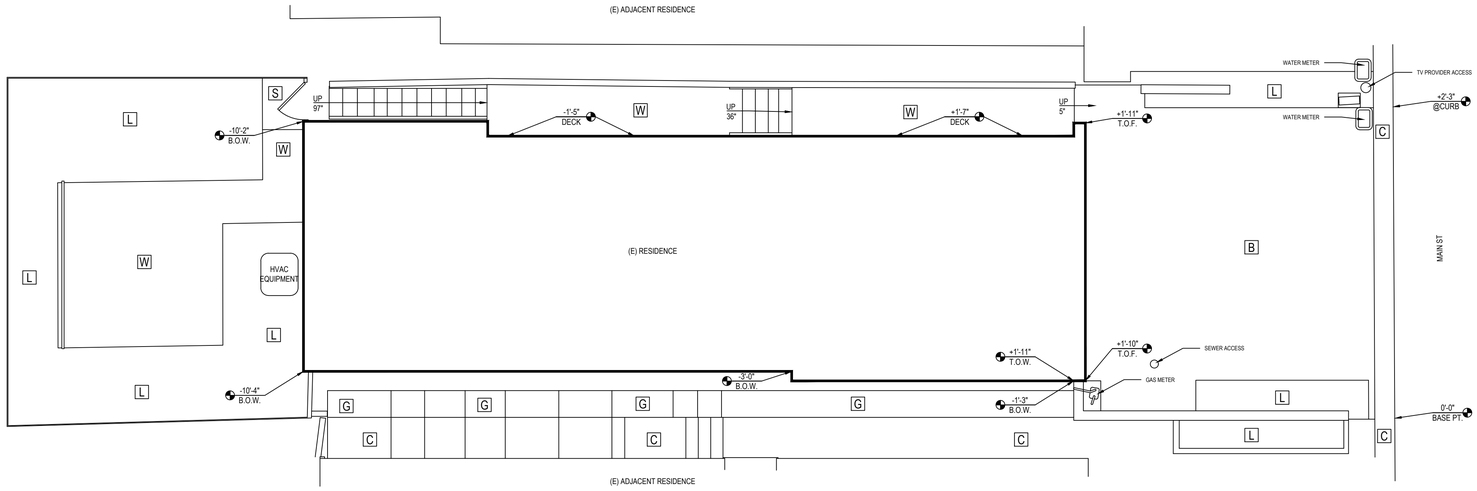


DRAWING LEGEND:

FLOWLINE
METAL FENCE
= STREET LIGHT
= STREET SIGN / POST
= UTILITY POLE
= AIR CONDITIONER
= UTILITY BOX
= WATER METER
= DRAIN
= FIRE HYDRANT
= SEWER / MAN-HOLE COVER
= IRRIGATION CONTROL VALVE
= HOSE BIB
= GAS METER
= ELECTRIC METER
= NATURAL GAS LINE
= DOWNSPOUT
A = ASPHALT
B = BRICK
C = CONCRETE
E = EQUIPMENT
G = GRAVEL
L = LANDSCAPE AREA
S = STONE / ROCKS
T = TILE
W = WOOD / DECK
0'-0" = SPOT ELEVATION
= TREES

MOSAIQ
EXPLORE THE BUILT ENVIRONMENT

2372 MORSE AVE | STE 304
IRVINE, CA 92614
T: 424-201-0808
W: MOSAIQUS.COM

REVISIONS

1 -

PREPARED FOR

RESIDENCE

PROJECT NAME

SANTA ANA

PROJECT ADDRESS

12345 MAIN ST
LAGUNA BEACH, CA 92651

PROJECT APN#

######

All plans created by Mosaiq LLC "Mosaiq" are made exclusively for design reference only (Cal. Bus. & Prof. Code §5537). All site plans created by Mosaiq do not involve the determination of any property line, and as such do not constitute land surveying (Cal. Bus. & Prof. Code §§5726-5727). In addition, Mosaiq does not perform any work of civil engineering (Cal. Bus. & Prof. Code §§5531-5704), and thus should not be used for any studies or activities defined as civil engineering (Cal. Bus. & Prof. Code §6731). All floor plans created by Mosaiq are intended to be used as a reference for design and construction and should not be considered a substitute for the services of a licensed structural engineer or licensed architect. Mosaiq makes every reasonable effort to ensure the accuracy of the dimensions shown on the plans; however, existing conditions may inherently contains errors to some degree. It is the duty of the architect, contractor, designer or other licensed professional, as a consultant to the property owner, to determine the suitability of the As-Built plans prior to construction. Measurements should be field confirmed before commencing construction. In the event that an error is found on a plan, Mosaiq's liability is limited to the amount of the fee paid to Mosaiq.

SCALE
3/16" = 1'-0"


PROJECT
M2208-019

APPROVED BY
TC


DATE
2025-12-31

DRAWING TYPE
SITE PLAN


SHEET
1 of 4

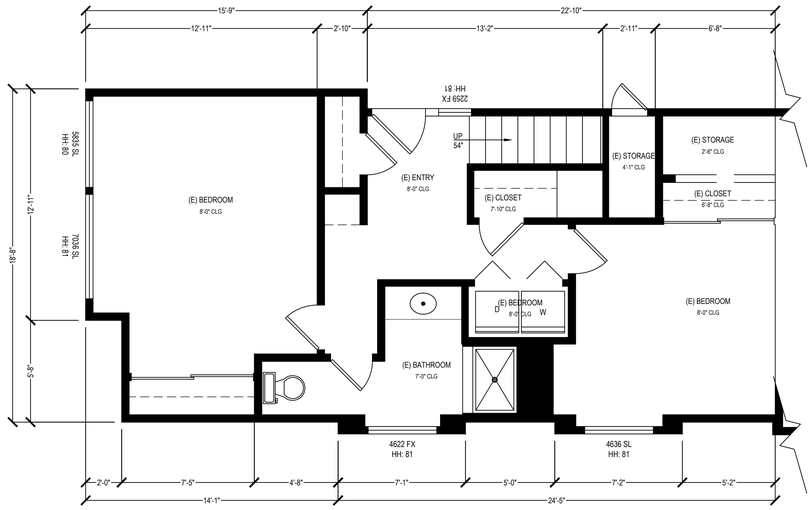


1 ENTRY LEVEL

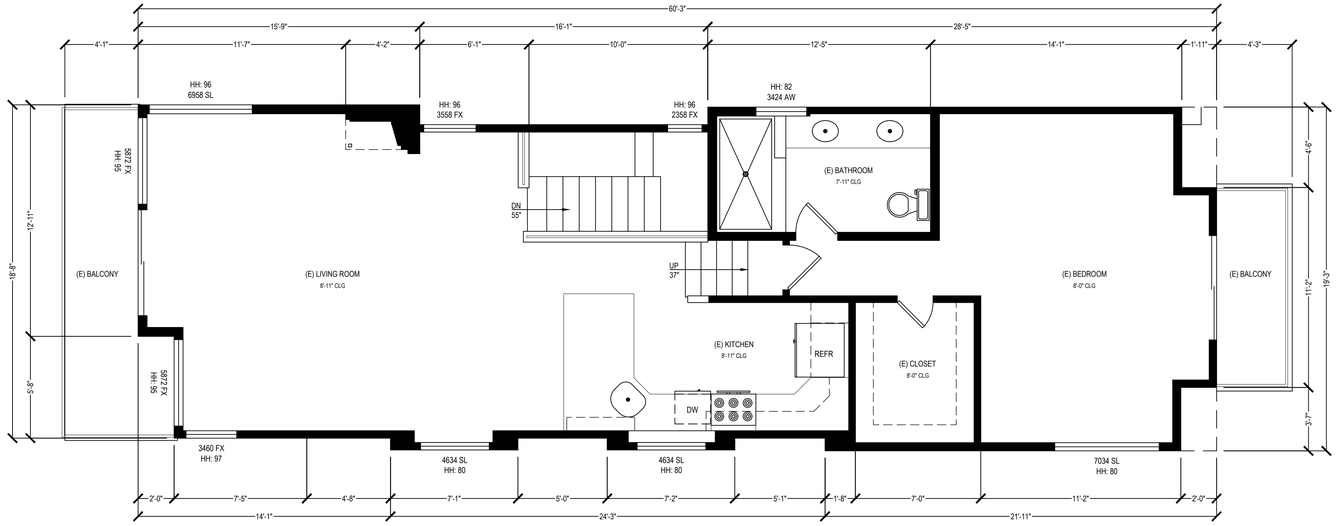

3 TOP LEVEL

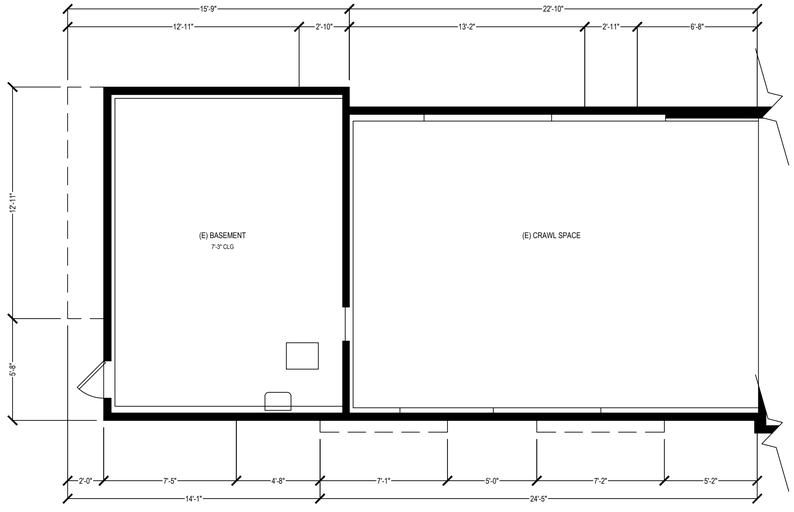

0 BASEMENT LEVEL

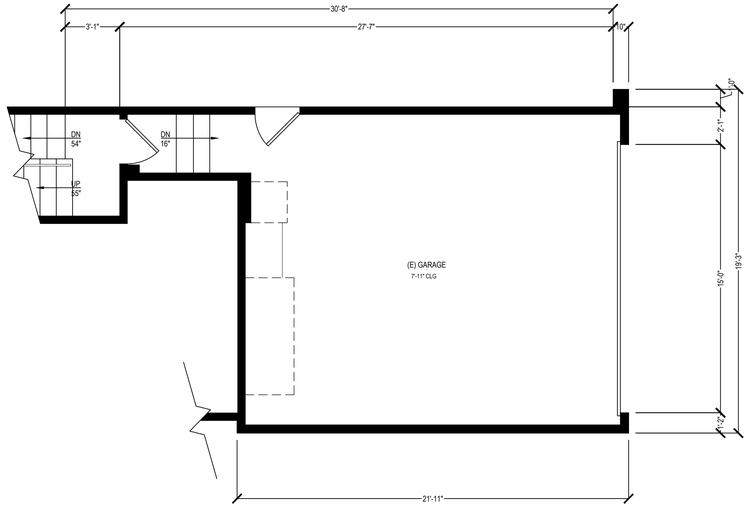

2 GARAGE LEVEL

DRAWING LEGEND:

COUNTER

UPPER CABINET

FULL HEIGHT CABINET

CLG = CEILING HEIGHT

MOSAIQ
EXPLORE THE BUILT ENVIRONMENT

2372 MORSE AVE | STE 304
IRVINE, CA 92614
T: 424-201-0808
W: MOSAIQUS.COM

REVISIONS

1 -

PREPARED FOR

RESIDENCE

PROJECT NAME

SANTA ANA

PROJECT ADDRESS

12345 MAIN ST
LAGUNA BEACH, CA 92651

PROJECT APN#

#######

All plans created by Mosaiq LLC "Mosaiq" are made exclusively for design reference only (Cal. Bus. & Prof. Code §5537). All site plans created by Mosaiq do not involve the determination of any property line, and as such do not constitute land surveying (Cal. Bus. & Prof. Code §§6735-6737). In addition, Mosaiq does not perform any structural engineering (Cal. Bus. & Prof. Code §§6703-6704), and thus should not be used for any studies or activities defined as civil engineering (Cal. Bus. & Prof. Code §6731). All floor plans created by Mosaiq are intended to be used as a reference for design and construction and should not be considered a substitute for the services of a licensed structural engineer or licensed architect. Mosaiq makes every reasonable effort to ensure the accuracy of the measurements and dimensions on the plans, however, all plans inherently contains errors to some degree. It is the duty of the architect, contractor, designer or other licensed professional, as a consultant to the property owner, to determine the suitability of the As-Built plans prior to construction. Measurements should be field confirmed before commencing construction. In the event that an error is found on a plan, Mosaiq's liability is limited to the amount of the fee paid to Mosaiq.

SCALE
SCALE
1/4" = 1'-0"


PROJECT
PROJECT
M2208-019

APPROVED BY
TC

DATE
2025-12-31

DRAWING TYPE
FLOOR PLAN


SHEET
2 of 4

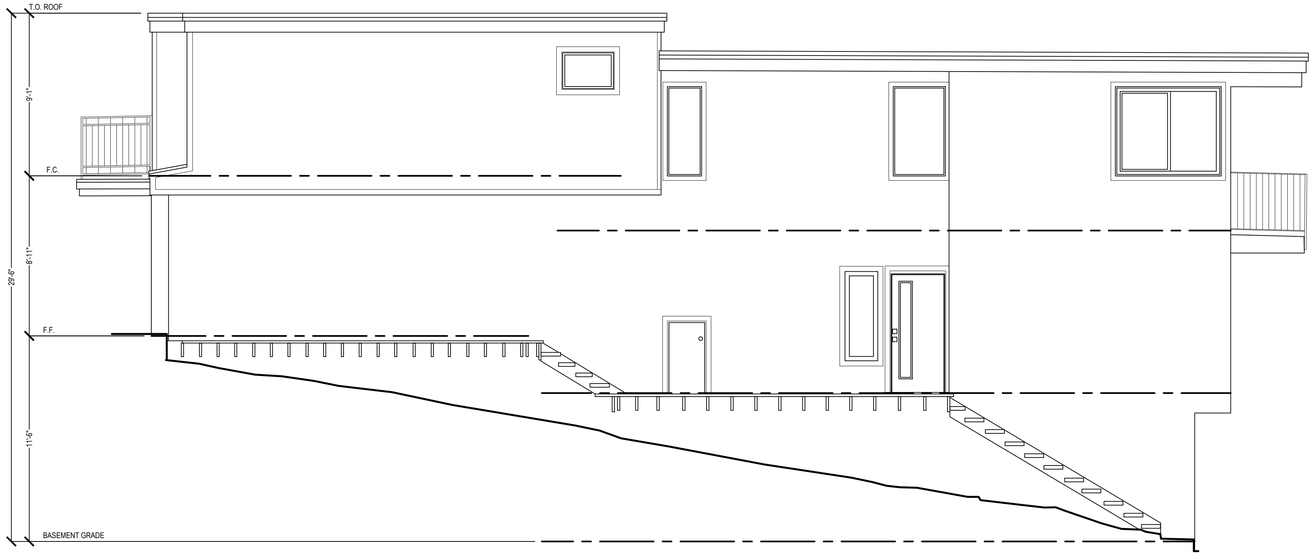


A (E) NORTH ELEVATION



B (E) WEST ELEVATION

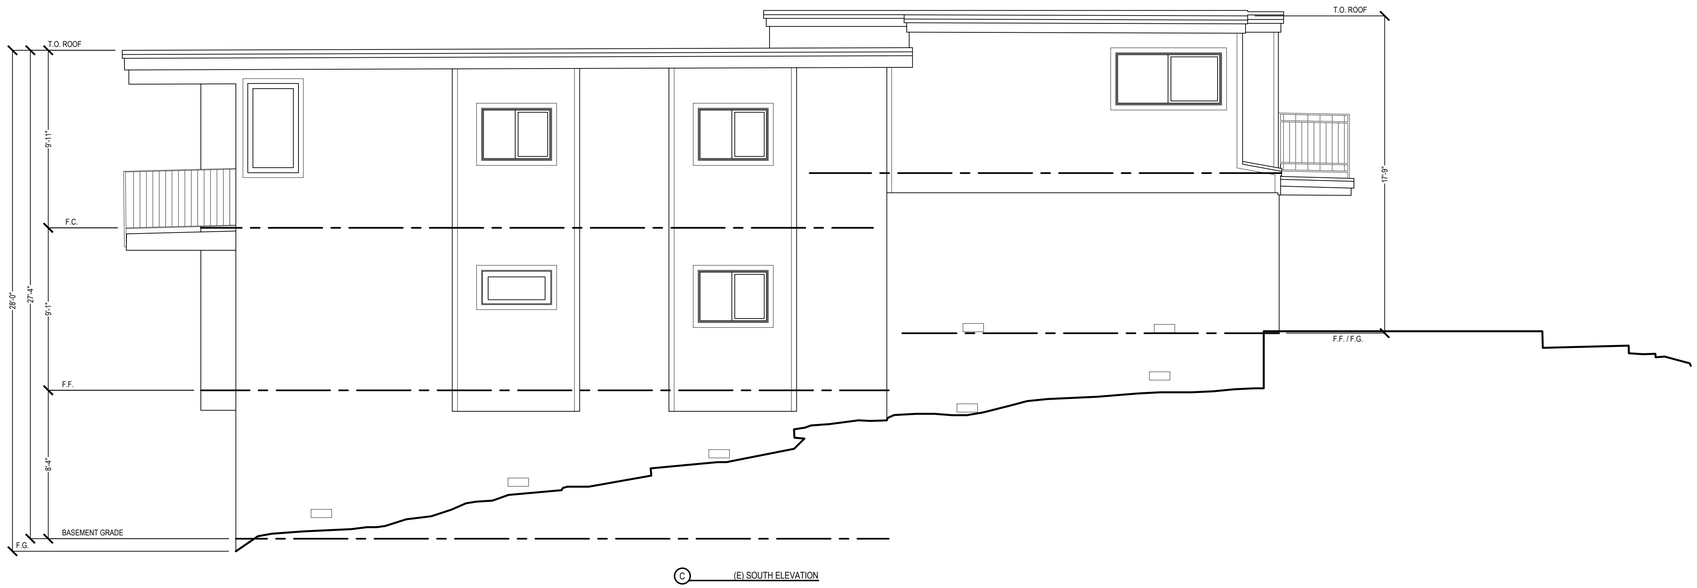

C (E) SOUTH ELEVATION

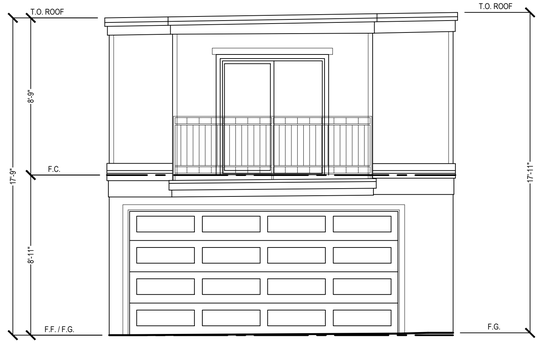

D (E) EAST ELEVATION

MOSAIQ
EXPLORE THE BUILT ENVIRONMENT

2372 MORSE AVE | STE 304
IRVINE, CA 92614
T: 424-201-0808
W: MOSAIQUS.COM

REVISIONS

1 -

PREPARED FOR

RESIDENCE

PROJECT NAME

SANTA ANA

PROJECT ADDRESS

12345 MAIN ST
LAGUNA BEACH, CA 92651

PROJECT APN#

#######

All plans created by Mosaiq LLC "Mosaiq" are made exclusively for design reference only (Cal. Bus. & Prof. Code §5537). All site plans created by Mosaiq do not involve the determination of any property line, and as such do not constitute land surveying (Cal. Bus. & Prof. Code §§5726-5727). In addition, Mosaiq does not perform any type of engineering (Cal. Bus. & Prof. Code §§5703-5704), and thus should not be used for any studies or activities defined as civil engineering (Cal. Bus. & Prof. Code §5731). All floor plans created by Mosaiq are intended to be used as a reference for design and construction and should not be considered a substitute for the services of a licensed structural engineer or licensed architect. Mosaiq makes every reasonable effort to ensure the accuracy of the dimensions shown on the plans; however, existing conditions may inherently contains errors to some degree. It is the duty of the architect, contractor, designer or other licensed professional, as a consultant to the property owner, to determine the suitability of the As-Built plans prior to construction. Measurements should be field confirmed before commencing construction. In the event that an error is found on a plan, Mosaiq's liability is limited to the amount of the fee paid to Mosaiq.

SCALE ¼" = 1'-0"


PROJECT M2208-019

APPROVED BY TC

DATE 2025-12-31

DRAWING TYPE
SECTION & EXT. ELEVATIONS

SHEET
3 of 4

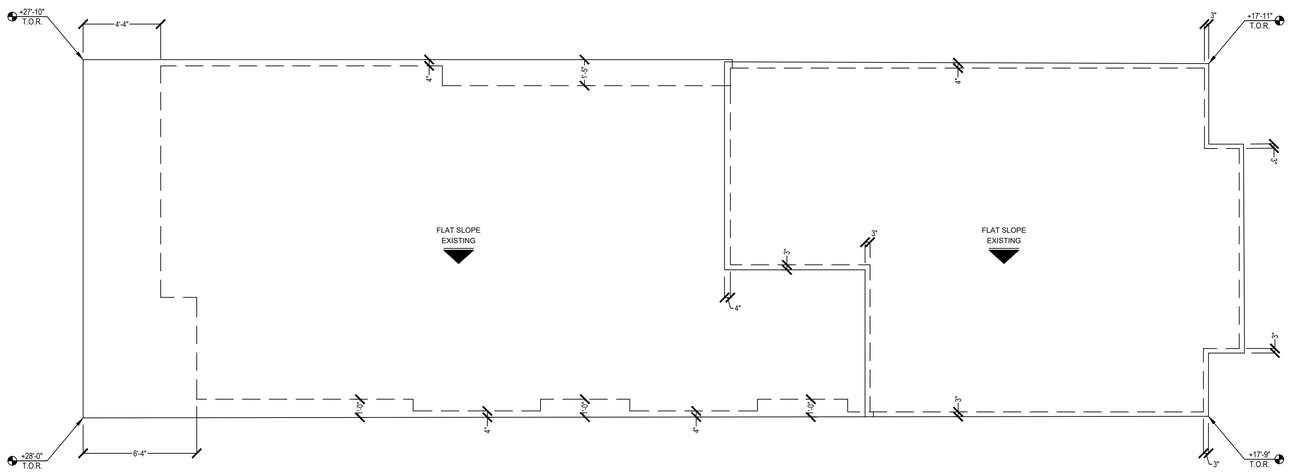

DRAWING LEGEND:

CHIMNEY

STRUCTURE FOOTPRINT

MOSAIQ
EXPLORE THE BUILT ENVIRONMENT

2372 MORSE AVE | STE 304
IRVINE, CA 92614
T: 424-201-0808
W: MOSAIQUS.COM

REVISIONS

1 -

PREPARED FOR

RESIDENCE

PROJECT NAME

SANTA ANA

PROJECT ADDRESS

12345 MAIN ST
LAGUNA BEACH, CA 92651

PROJECT APN#

######

All plans created by Mosaiq LLC "Mosaiq" are made exclusively for design reference only (Cal. Bus. & Prof. Code §5727). All site plans created by Mosaiq do not involve the determination of any property line, and as such do not constitute land surveying. (Cal. Bus. & Prof. Code §8726-8727). In addition, Mosaiq services do not constitute soil engineering (Cal. Bus. & Prof. Code §§5703-5704), and thus should not be used for any studies or activities defined as civil engineering (Cal. Bus. & Prof. Code §5731). All floor plans created by Mosaiq are intended to be used as a reference for design and construction and should not be considered a substitute for the services of a licensed structural engineer or licensed architect. Mosaiq makes every reasonable effort to ensure the accuracy of the Existing Condition Plans; however, as-built drawings may inherently contains errors to some degree. It is the duty of the architect, contractor, designer or other licensed professional, as a consultant to the property owner, to determine the suitability of the As-Built plans prior to construction. Measurements should be field confirmed before commencing construction. In the event that an error is found on a plan, Mosaiq's liability is limited to the amount of the fee paid to Mosaiq.

SCALE
SCALE
¼" = 1'-0"

PROJECT
PROJECT
M2208-019

APPROVED BY
TC

DATE
2025-12-31

DRAWING TYPE
ROOF PLAN

SHEET
4 of 4