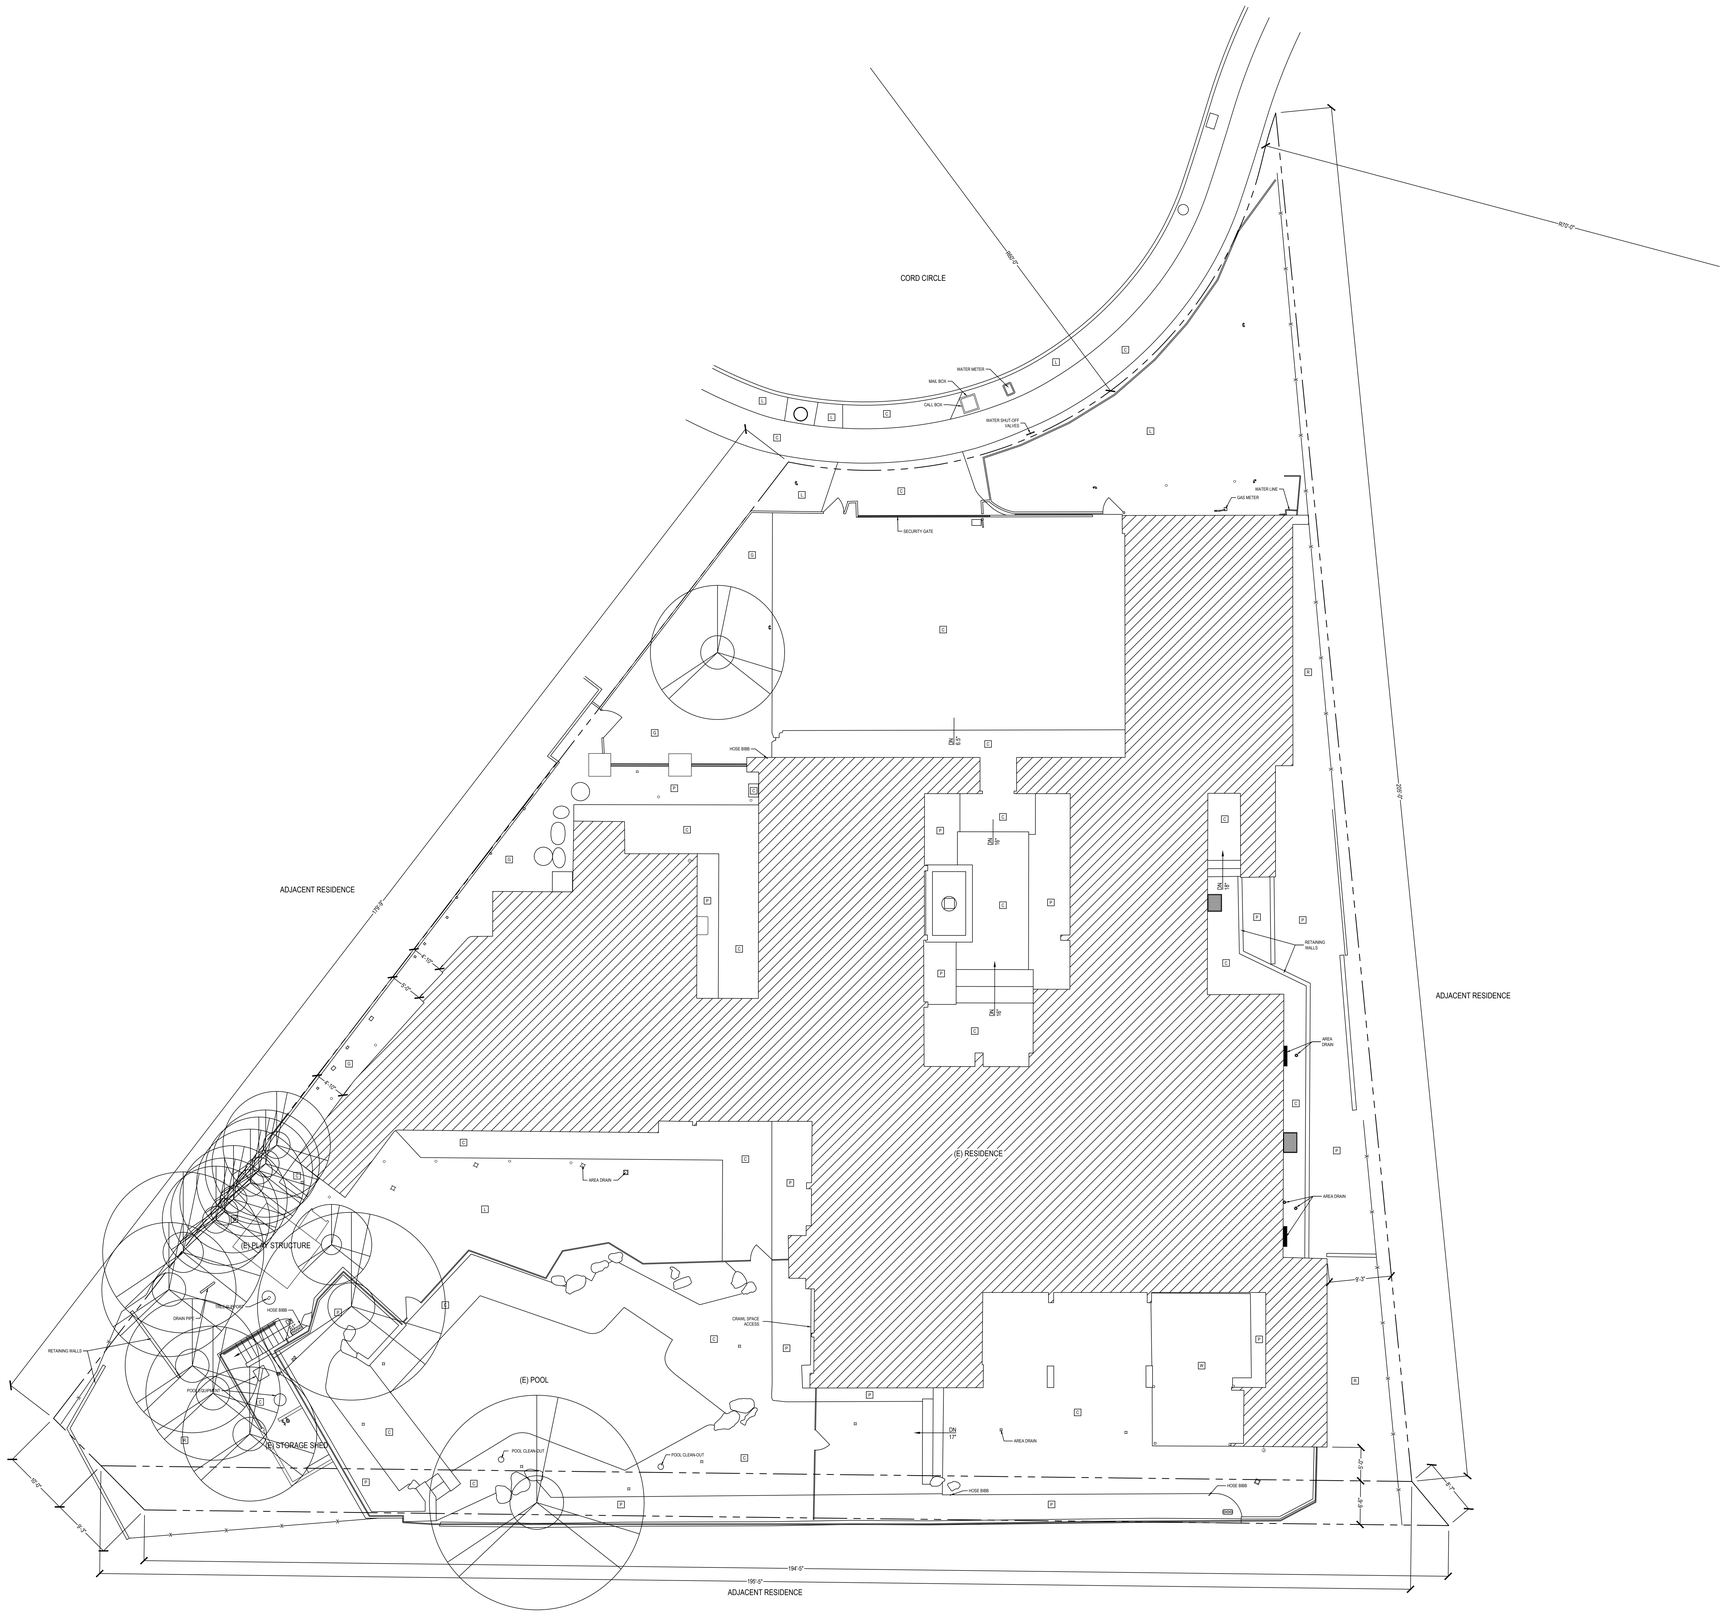


DRAWING LEGEND:

FLOWLINE
METAL FENCE
= STREET LIGHT
= STREET SIGN / POST
= UTILITY POLE
= AIR CONDITIONER
= UTILITY BOX
= WATER METER
= DRAIN
= FIRE HYDRANT
= SEWER / MAN-HOLE COVER
= IRRIGATION CONTROL VALVE
= HOSE BIB
= GAS METER
= ELECTRIC METER
= NATURAL GAS LINE
= DOWNSPOUT
A = ASPHALT
B = BRICK
C = CONCRETE
E = EQUIPMENT
G = GRAVEL
L = LAWN
P = PLANTER/LANDSCAPER
R = RAW GRADE
T = TILE
W = WOOD / DECK
0'-0" NOTE = SPOT ELEVATION
= TREES

ABBREVIATIONS:

A.A.A.	= TOP OF CURB	B.O.W.	= BOTTOM OF WALL
B.O.C.	= BOTTOM OF CURB	F.F.	= FINISH FLOOR/HARDSCAPE
T.O.S.	= TOP OF STAIRS	F.G.	= FINISH GRADE
B.O.S.	= BOTTOM OF STAIRS	G.C.	= GROUND COVER
T.O.W.	= TOP OF WALL	TURF	= TURF

MOSAIQ
EXPLORE THE BUILT ENVIRONMENT

2372 MORSE AVE | STE 304
IRVINE, CA 92614
T: 818-613-1215
W: MOSAIQUS.COM

REVISIONS

1 -

3/16" = 1'-0"

PREPARED FOR

MOSAIQ

PROJECT NAME

PROJECT

PROJECT ADDRESS

123 MAIN ST
ANYTOWN, USA

PROJECT APN#

1234-567-890

All plans created by Mosaiq LLC "Mosaiq" are made exclusively for design reference only (Cal. Bus. & Prof. Code §5721). All site plans created by Mosaiq are based on information provided by others that is not in all cases verified and surveyed (Cal. Bus. & Prof. Code §§5726-5727). In addition, Mosaiq services and plans do not constitute civil engineering (Cal. Bus. & Prof. Code §§6701-6704) and Mosaiq is not responsible for any structural or retaining walls that are not engineering (Cal. Bus. & Prof. Code §5721). All floor plans created by Mosaiq are intended to be used as a guide for professional architectural drawings and must be considered a substitute for the services of a licensed structural engineer or licensed architect. Mosaiq makes every reasonable effort to ensure the accuracy of the information used to prepare its plans, however, errors in drawing inherently contains errors to some degree. It is the duty of the architect, contractor, designer or other licensed professional, as a condition precedent to the use of Mosaiq plans, to verify all of Mosaiq's plans prior to construction. Measurements should be field confirmed before commencing construction. In the event that an error is found on a plan, Mosaiq's liability is limited to the amount of the fee paid to Mosaiq.

SCALE

1/8" = 1'-0"

PROJECT

m2608-20

APPROVED BY

TC

DATE

2026-09-22

DRAWING TYPE

SITE PLAN

SHEET

1 of 6

DRAWING LEGEND:

COUNTER

UPPER CABINET

FULL HEIGHT CABINET

CLG = CEILING HEIGHT

MOSAIQ
EXPLORE THE BUILT ENVIRONMENT

2372 MORSE AVE | STE 304
IRVINE, CA 92614
T: 818-613-1215
W: MOSAIQUS.COM

REVISIONS

1 -

PREPARED FOR

MOSAIQ

PROJECT NAME

PROJECT

PROJECT ADDRESS

123 MAIN ST
ANYTOWN, USA

PROJECT APN#

1234-567-890

All plans created by Mosaiq LLC "Mosaiq" are made exclusively for design reference only (Cal. Bus. & Prof. Code §5777). All data plans created by Mosaiq are approximate and are not intended to be used as such do not constitute land surveying (Cal. Bus. & Prof. Code, §§8726-8727). In addition, Mosaiq services and plans do not constitute civil engineering (Cal. Bus. & Prof. Code §6731). Mosaiq does not warrant or guarantee any structural or architectural element as all engineering (Cal. Bus. & Prof. Code §5777). All floor plans created by Mosaiq are intended to be used as a guide for the client, general contractor, architect and/or engineer convenient as a substitute for the services of a licensed structural engineer or licensed architect. Mosaiq makes every reasonable effort to ensure the accuracy of the representations shown in the plans; however, errors in the drawing inherently contains errors to some degree. It is the duty of the architect, contractor, designer or other licensed professional, as a condition precedent to the use of the plans, to independently verify all plans prior to construction. Measurements should be field confirmed before commencing construction. In the event that an error is found on a plan, Mosaiq's liability is limited to the amount of the fee paid to Mosaiq.

SCALE

1/4" = 1'-0"

PROJECT

m2608-20

APPROVED BY

TC

DATE


2026-09-22

DRAWING TYPE

FLOOR PLAN

SHEET

2 of 6

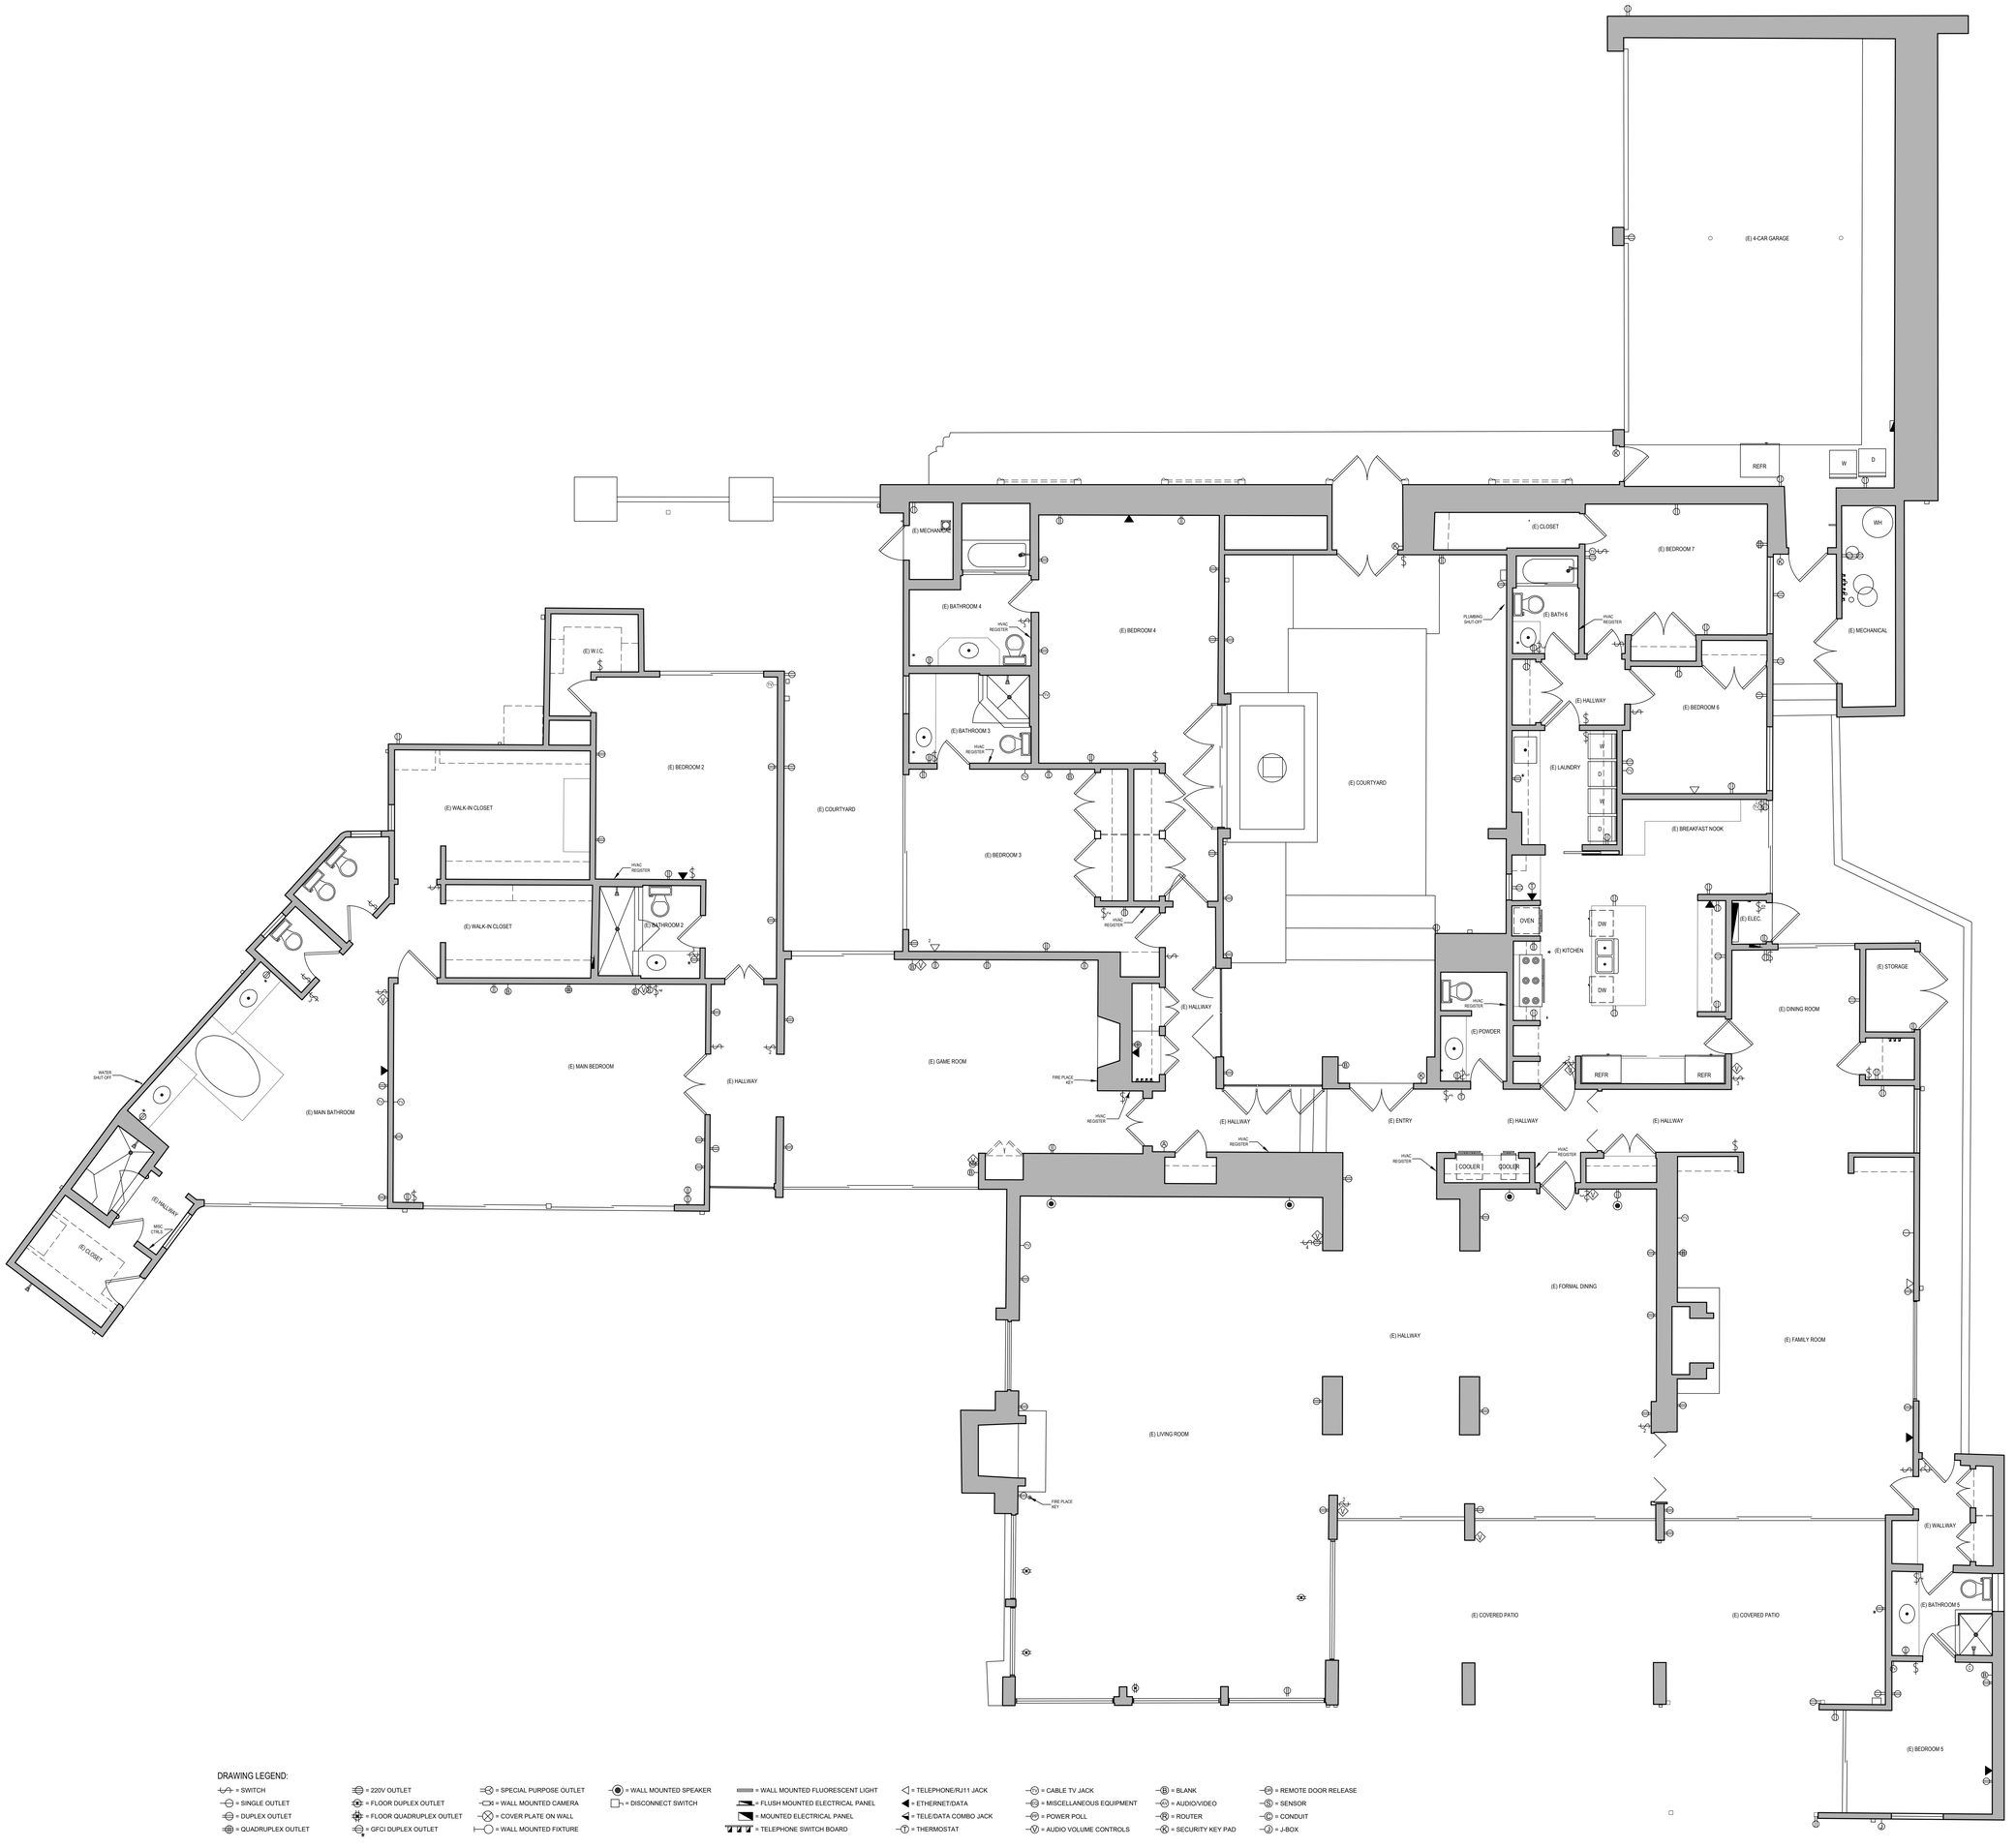

DRAWING LEGEND:

- = SWITCH
- = SINGLE OUTLET
- = DUPLEX OUTLET
- = QUADRUPLEX OUTLET
- = 220V OUTLET
- = FLOOR DUPLEX OUTLET
- = FLOOR QUADRUPLEX OUTLET
- = GFCI DUPLEX OUTLET
- = SPECIAL PURPOSE OUTLET
- = WALL MOUNTED CAMERA
- = COVER PLATE ON WALL
- = WALL MOUNTED FIXTURE
- = WALL MOUNTED SPEAKER
- = DISCONNECT SWITCH
- = WALL MOUNTED FLUORESCENT LIGHT
- = FLUSH MOUNTED ELECTRICAL PANEL
- = MOUNTED ELECTRICAL PANEL
- = TELEPHONE SWITCH BOARD
- = TELEPHONE/RJ11 JACK
- = ETHERNET/DATA
- = TELE/DATA COMBO JACK
- = THERMOSTAT
- = CABLE TV JACK
- = MISCELLANEOUS EQUIPMENT
- = POWER POLL
- = AUDIO VOLUME CONTROLS
- = BLANK
- = AUDIO/VIDEO
- = ROUTER
- = SECURITY KEY PAD
- = REMOTE DOOR RELEASE
- = SENSOR
- = CONDUIT
- = J-BOX

MOSAIQ
EXPLORE THE BUILT ENVIRONMENT

2372 MORSE AVE | STE 304
IRVINE, CA 92614
T: 818-613-1215
W: MOSAIQUS.COM

REVISIONS

1 -

PREPARED FOR

MOSAIQ

PROJECT NAME

PROJECT

PROJECT ADDRESS

123 MAIN ST
ANYTOWN, USA

PROJECT APN#

1234-567-890

All plans created by Mosaiq LLC ("Mosaiq") are made exclusively for design reference only (Cal. Bus. & Prof. Code §5131). All site plans created by Mosaiq do not involve the determination of any property line, and as such, are not considered a survey (Cal. Bus. & Prof. Code §§5731(a)(1), 8726(a)(1)). In addition, Mosaiq services and plans do not constitute civil engineering (Cal. Bus. & Prof. Code §§8700-8794), and thus should not be relied upon for any purpose that requires a civil engineer (Cal. Bus. & Prof. Code §5731). All floor plans created by Mosaiq are deemed to be used as a reference for design and construction and should not be considered accurate for any purpose that requires the expertise of a licensed architect. Mosaiq makes every reasonable effort to ensure the accuracy of the information found in our plans. However, every As-Built condition is unique and should be verified by the owner, his or her architect, contractor, designer or other licensed professional, as a consultant to the property owner, to determine the suitability of the As-Built plans for construction, modification, or repair. Prior to the start of any commencing construction, in the event that an error is found on a plan, Mosaiq's liability is limited to the amount of the fee paid to Mosaiq.

SCALE

¼" = 1'-0"

PROJECT

m2608-20

APPROVED BY

TC

DATE


2026-09-22

DRAWING TYPE

ELECTRICAL PLAN

SHEET

3 of 6

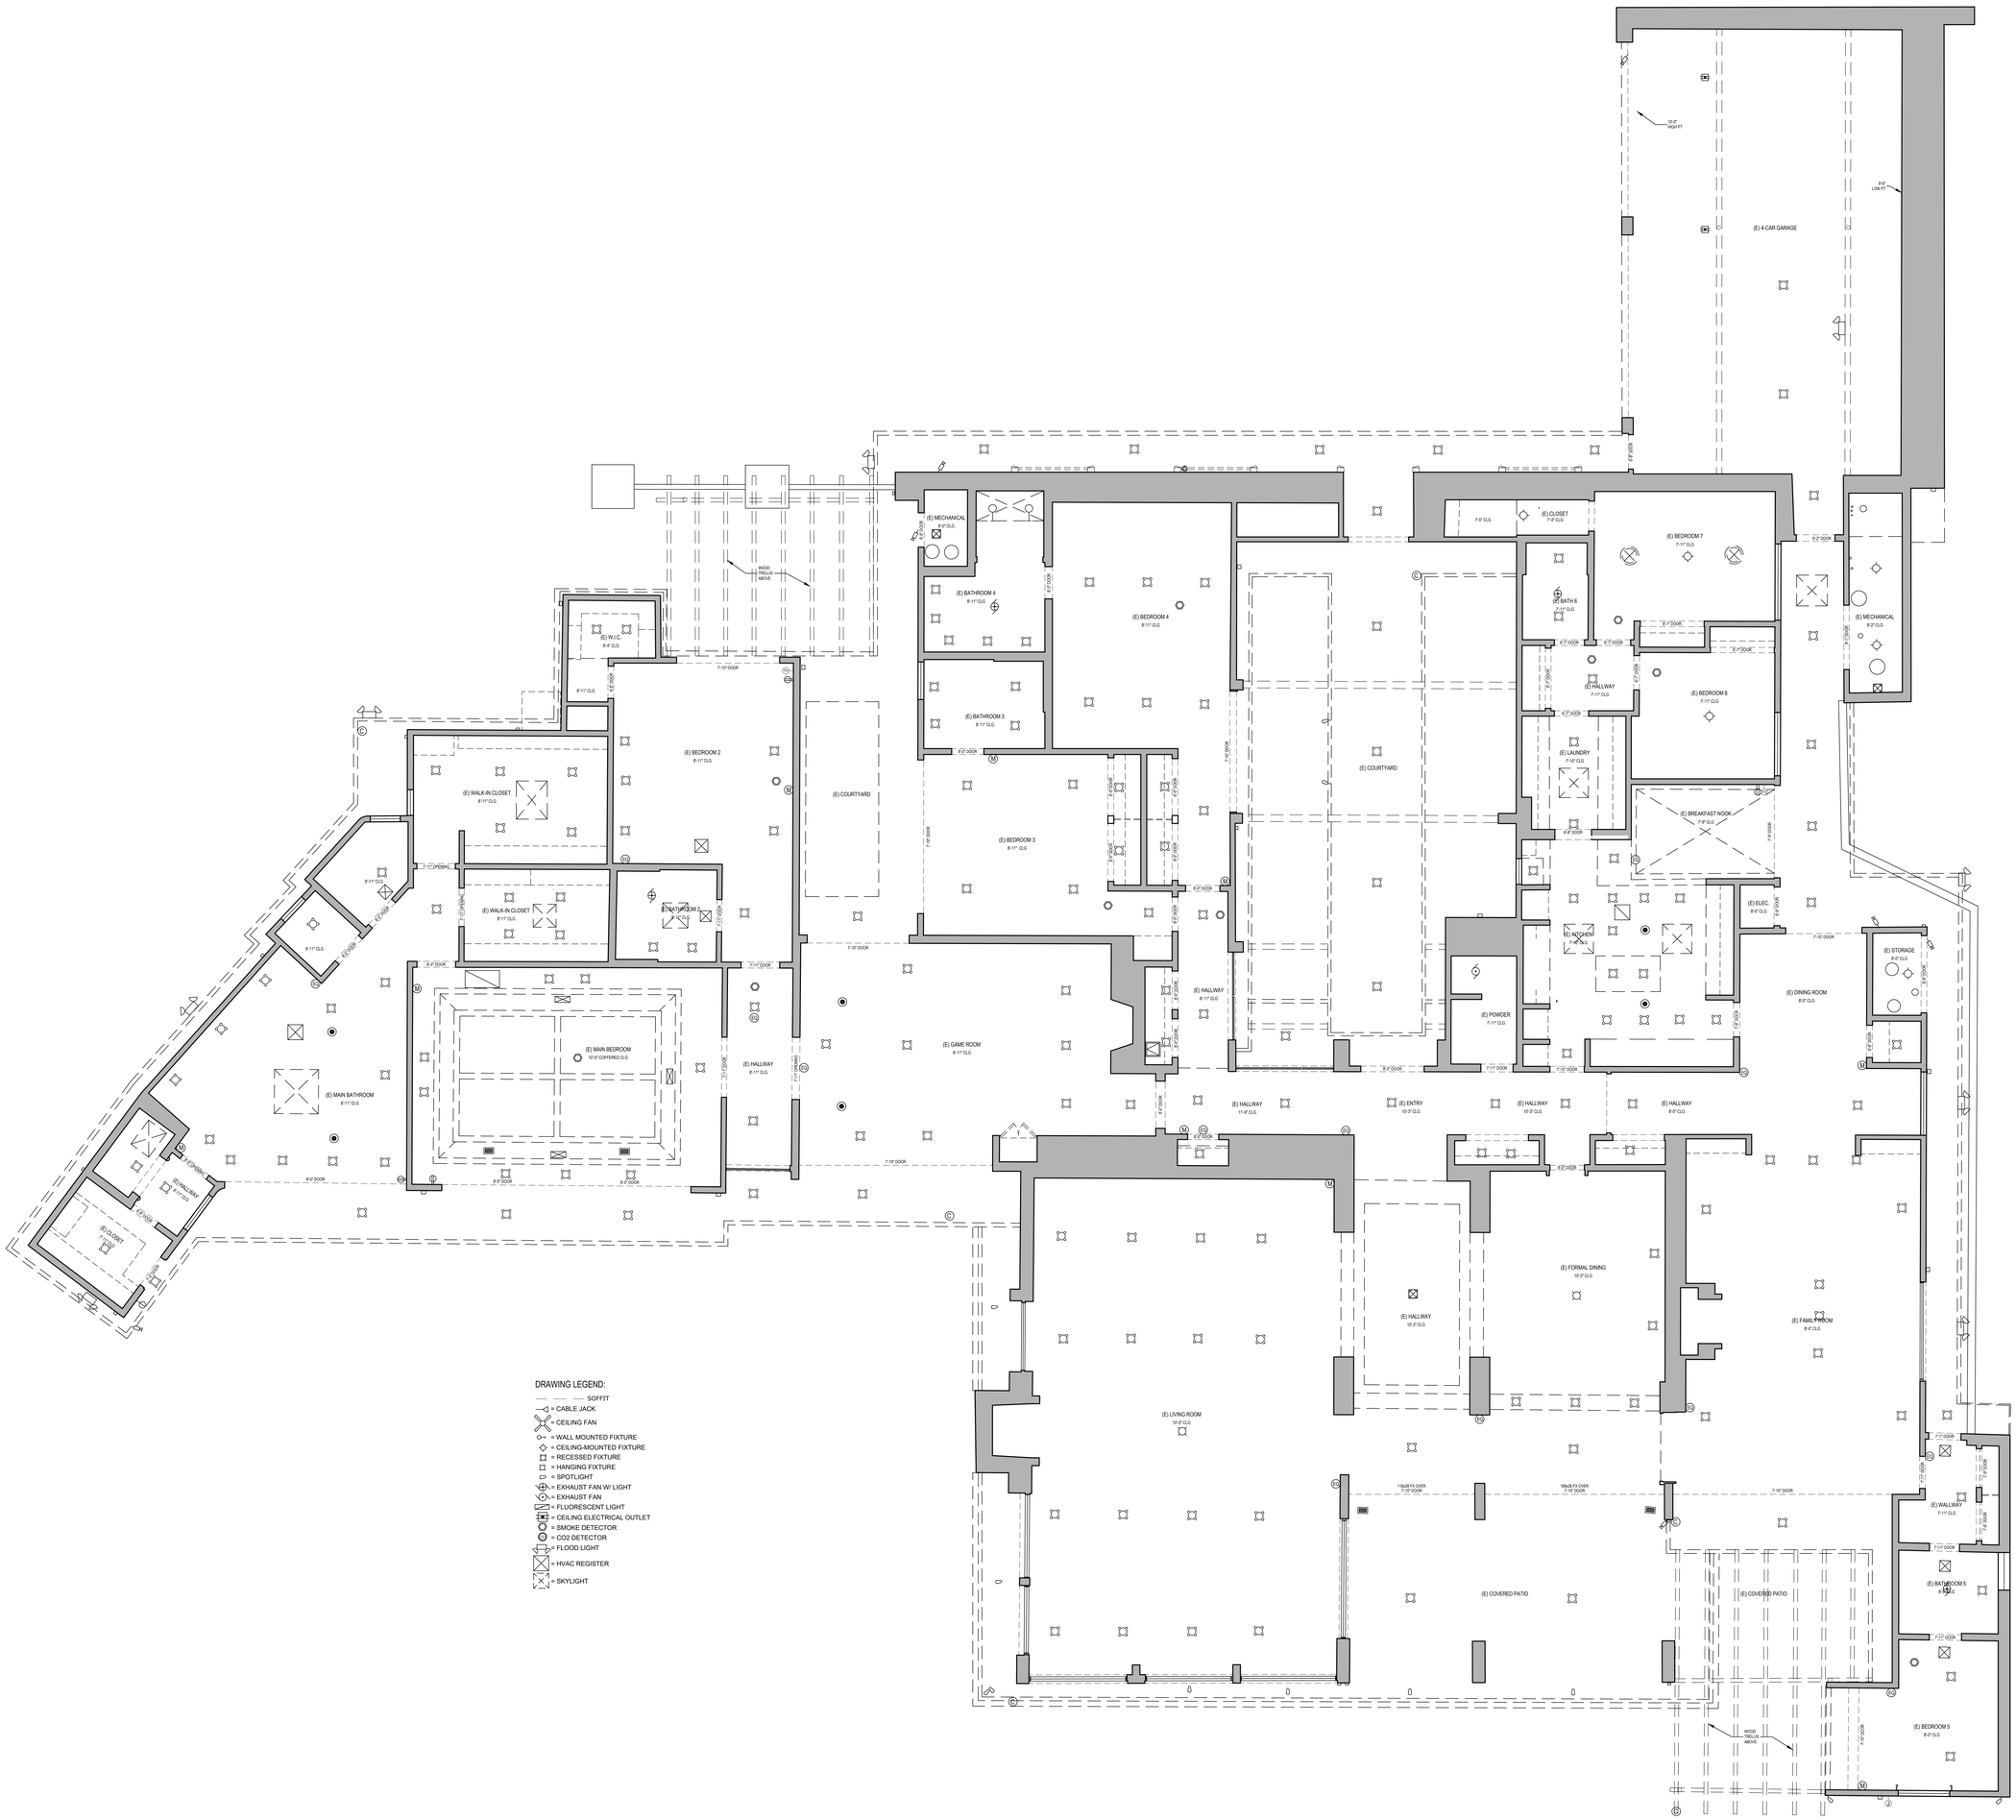

DRAWING LEGEND:

- SOFFIT
- = CABLE JACK
- = CEILING FAN
- = WALL MOUNTED FIXTURE
- = CEILING-MOUNTED FIXTURE
- = RECESSED FIXTURE
- = HANGING FIXTURE
- = SPOTLIGHT
- = EXHAUST FAN W/ LIGHT
- = EXHAUST FAN
- = FLUORESCENT LIGHT
- = CEILING ELECTRICAL OUTLET
- = SMOKE DETECTOR
- = CO2 DETECTOR
- = FLOOD LIGHT
- = HVAC REGISTER
- = SKYLIGHT

MOSAIQ
EXPLORE THE BUILT ENVIRONMENT

2372 MORSE AVE | STE 304
IRVINE, CA 92614
T: 818-613-1215
W: MOSAIQUS.COM

REVISIONS

1 -

PREPARED FOR

MOSAIQ

PROJECT NAME

PROJECT

PROJECT ADDRESS

123 MAIN ST
ANYTOWN, USA

PROJECT APN#

1234-567-890

All plans created by Mosaiq LLC "Mosaiq" are made exclusively for design reference only (Cal. Bus. & Prof. Code §5537). All site plans created by Mosaiq are approximate and are not intended to be used as such for civil construction land surveying (Cal. Bus. & Prof. Code, §§5726-5731). In addition, Mosaiq services and plans do not constitute civil engineering (Cal. Bus. & Prof. Code §6731) or architecture (Cal. Bus. & Prof. Code §5537) and are not to be used as an engineering (Cal. Bus. & Prof. Code §6731) or architecture (Cal. Bus. & Prof. Code §5537). All floor plans created by Mosaiq are intended to be used as a reference only. Mosaiq recommends that a professional be consulted to build/do for the services of a licensed structural engineer or licensed architect. Mosaiq makes every reasonable effort to ensure the accuracy of the dimensions, square footage, and layout of the plans. Mosaiq inherently contains errors to some degree. It is the duty of the architect, engineer, designer or other licensed professional, as built plans prior to construction. Measurements should be field confirmed before construction, fabrication or purchase of any materials. Mosaiq's liability is limited to the amount of the fee paid to Mosaiq.

SCALE

1/4" = 1'-0"

PROJECT

m2608-20

APPROVED BY

TC

DATE


2026-09-22

DRAWING TYPE

REFLECTED CEILING PLAN

SHEET

4 of 6

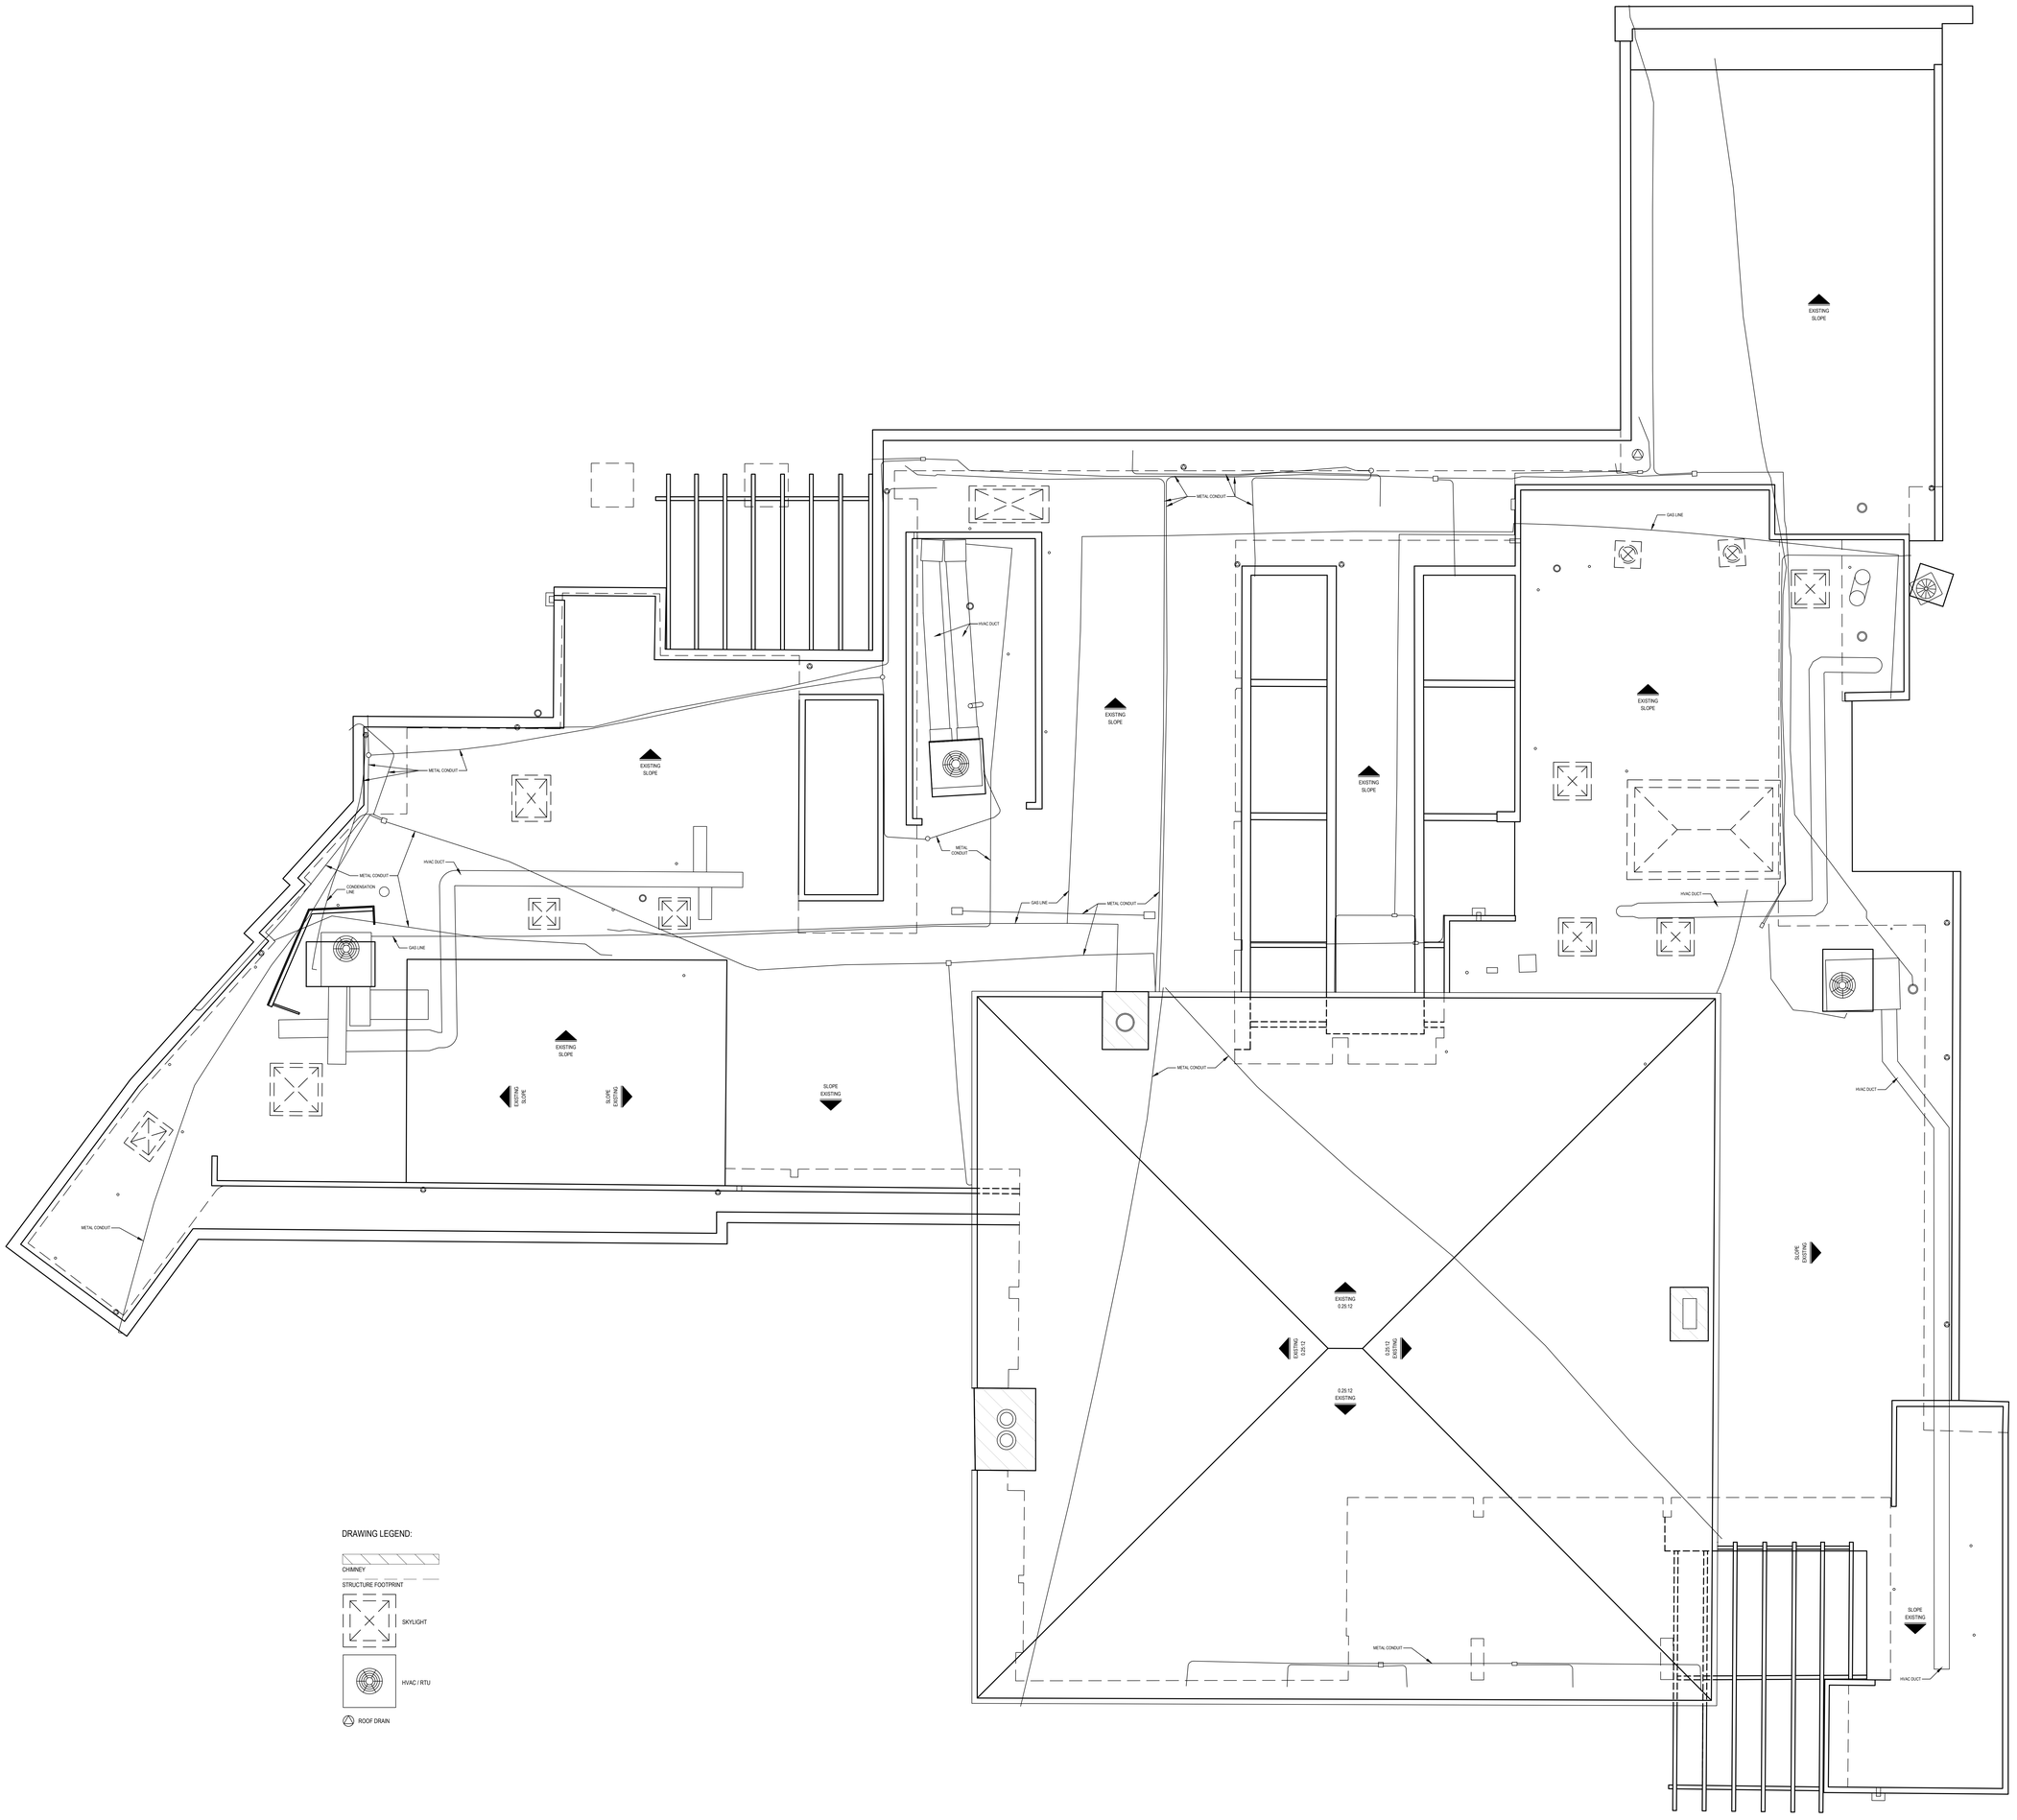

DRAWING LEGEND:

- CHIMNEY
- STRUCTURE FOOTPRINT
- SKYLIGHT
- HVAC / RTU
- ROOF DRAIN

MOSAIQ
EXPLORE THE BUILT ENVIRONMENT

2372 MORSE AVE | STE 304
IRVINE, CA 92614
T: 818-613-1215
W: MOSAIQUS.COM

REVISIONS

1 -

PREPARED FOR

MOSAIQ

PROJECT NAME

PROJECT

PROJECT ADDRESS

123 MAIN ST
ANYTOWN, USA

PROJECT APN#

1234-567-890

All plans created by Mosaiq LLC "Mosaiq" are made exclusively for design reference only (Cal. Bus. & Prof. Code §5537). All site plans created by Mosaiq are based on information provided by the client and as such is not construction level surveying (Cal. Bus. & Prof. Code, §§5726-5727). In addition, Mosaiq services and plans is not considered civil engineering (Cal. Bus. & Prof. Code §§6731). Mosaiq does not perform nor claim to be versed for any studies or activities defined as civil engineering (Cal. Bus. & Prof. Code §§6731). Mosaiq plans and services are for design reference only and are a reference for design and construction and should not be interpreted as such by the end user of a licensed architect and engineer or contractor. Mosaiq does not warrant, guarantee or represent the correctness or accuracy of the information found in our plans. However, every As-Built condition should be verified and approved by the client, as well as their architect, contractor, designer or other licensed professional, or a consultant to the property owner, to determine the suitability of the As-Built conditions for construction, prior to purchase of any materials or commencement of any construction, or in the event that an error is found on a plan. Mosaiq's liability is limited to the amount of the fee paid to Mosaiq.

SCALE

¼" = 1'-0"

PROJECT

m2608-20

APPROVED BY

TC

DATE


2026-09-22

DRAWING TYPE


ROOF PLAN

SHEET


5 of 6

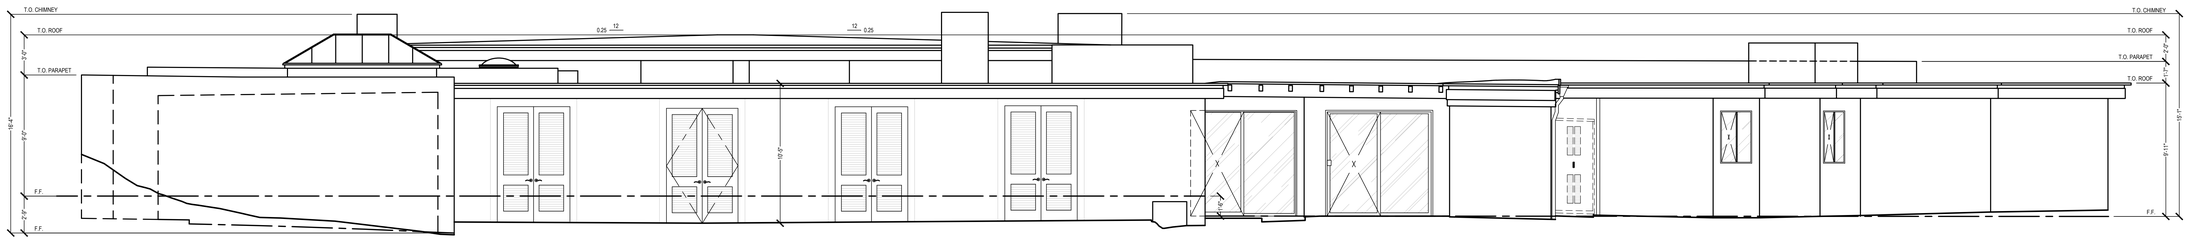


A NORTH ELEVATION

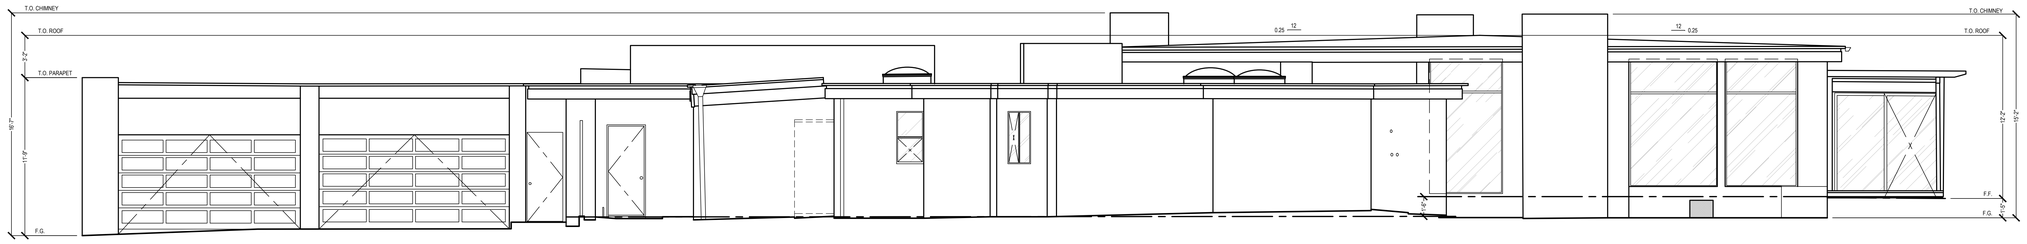

B WEST ELEVATION

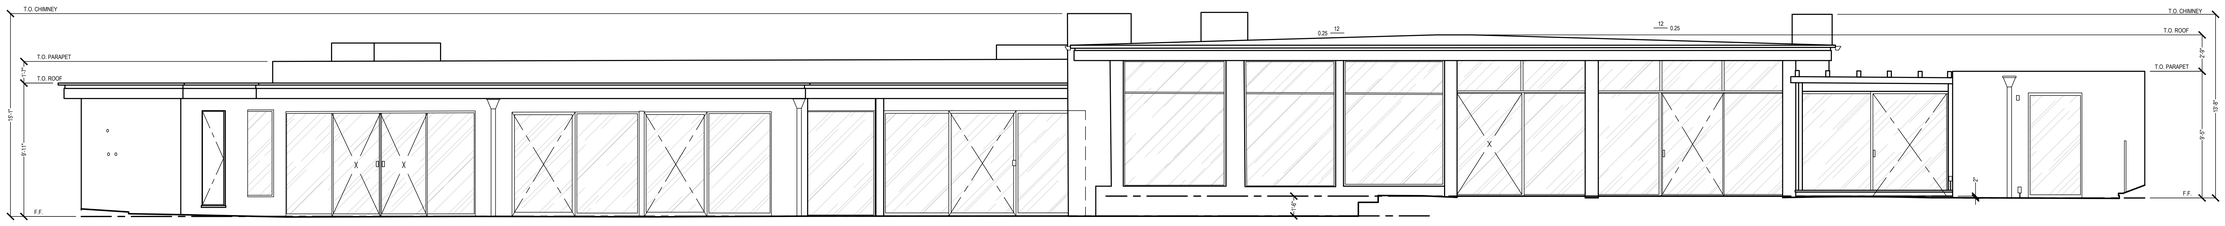

C SOUTH ELEVATION

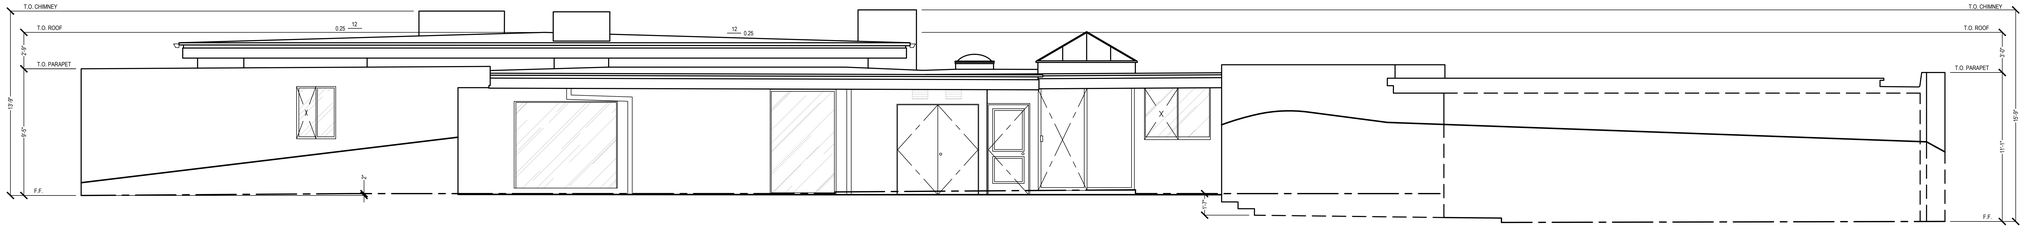

D EAST ELEVATION

MOSAIQ
EXPLORE THE BUILT ENVIRONMENT

2372 MORSE AVE | STE 304
IRVINE, CA 92614
T: 818-613-1215
W: MOSAIQUS.COM

REVISIONS

1 -

PREPARED FOR

MOSAIQ

PROJECT NAME

PROJECT

PROJECT ADDRESS

123 MAIN ST
ANYTOWN, USA

PROJECT APN#

1234-567-890

All plans created by Mosaiq LLC "Mosaiq" are made exclusively for construction purposes. The use of any plans by Mosaiq is not intended to be Mosaiq do not involve the determination of any property line, and as such do not constitute land surveying (Cal. Bus. & Prof. Code §§8726(a)(b)(c)(d)(e)(f)(g)(h)(i)(j)(k)(l)(m)(n)(o)(p)(q)) or professional civil engineering (Cal. Bus. & Prof. Code §§6731(4),(5)), and thus should not be used for any studies or activities defined as civil engineering (Cal. Bus. & Prof. Code §6731). The plans and information contained herein are not to be used as a reference for design and construction and should not be considered a substitute for the services of a licensed structural engineer or other professional. Mosaiq makes no representations as to the accuracy or completeness or accuracy of the information found in our plans. However, every As-Built drawing inherently contains errors to some degree. It is the duty of the contractor to report any errors, omissions or discrepancies that may be concealed to the property owner, to determine the suitability of the As-Built plans prior to construction. Measurements should be field confirmed before any construction commences. Mosaiq's liability is limited to the amount of the fee paid to Mosaiq.

SCALE

¼" = 1'-0"

PROJECT

m2608-20

APPROVED BY

TC

DATE

2026-09-22

DRAWING TYPE

SECTION & EXT. ELEVATIONS

SHEET

6 of 6